


Sumner

KANSAS

SECTION 22 TOWNSHIP 34S RANGE 3W

WELL NO. #7 Subera

COMPANY Herndon

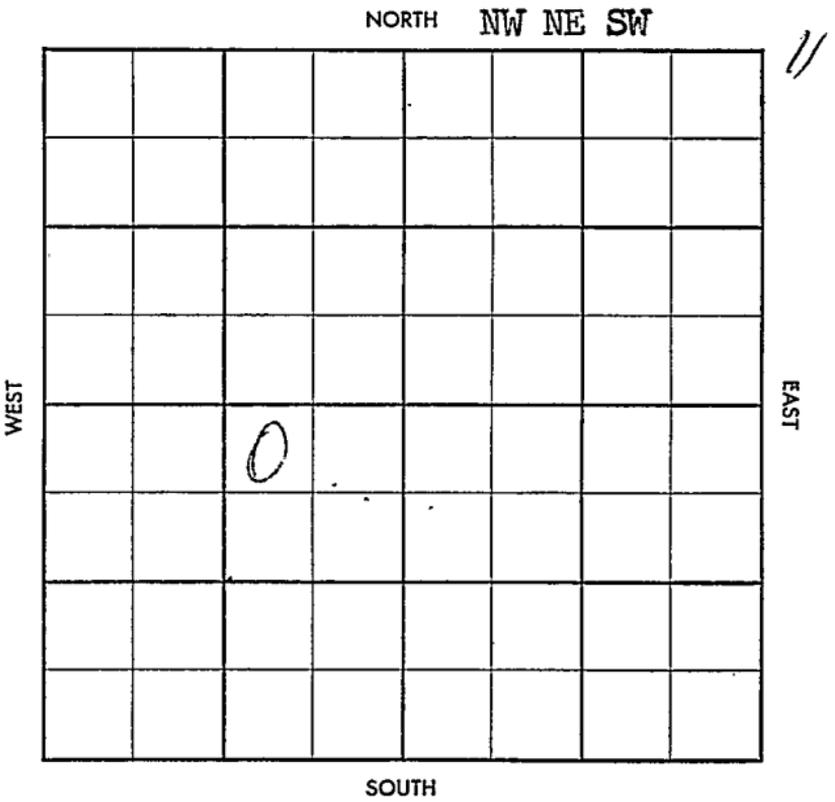

CO. Summer ELEV. 119.50
SEC. 22 TWP. 34 RGE. 3W
COMPANY Herndon NO. 7

COMPLETE

FEB 5 '58

FARM Subera

LOC. NW NE SW

M	4287
S	4530 4731
TD	4742

GEOL. _____
CONTR. Co. tools
POOL Subera

SPUD 12-21-57

setting surface

JAN 2 '58 8" 650/400

Ø 2325 JAN 8 '58

Ø 3975

JAN 15 '58 DST 473028

42 60" 9.15"

630' 0" 30' 06 gcm B HP

1355 JAN 2 '58 5 1/2 4733/100

JAN 2 '58 20 4742 5 1/2 Flo 10Boph

NW 16 hrs 51 FEB 5 '58 Flo 6Boph

nw Phy Flo 143 BOP

190w g 50°

LSE. NO. SEC. TWP. RGE.

