


DX 78-1 Barber

Section 22 Township 34 Range 11W

Well No. #1 Schupback

Company Purcell & Mull

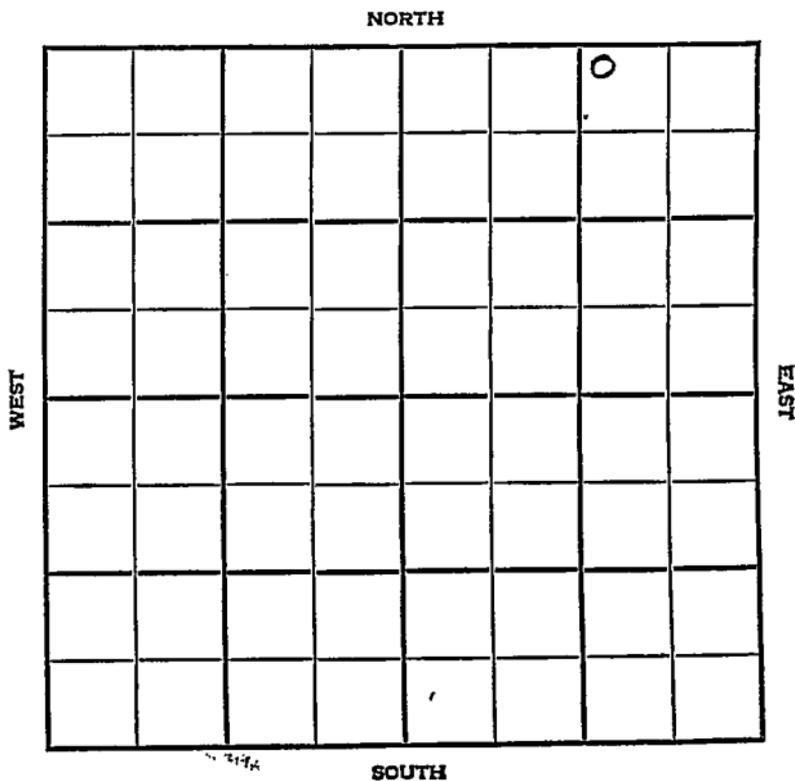

Barber

KANSAS

SEC. 22	TWP. 34	R. 11W
------------	------------	-----------

WELL NO. #1 Schupback FARM

COMPANY Purcell & Mull

CONTRACTOR


Wildcat

_____ Ft. from N. Line

_____ Ft. from S. Line

_____ Ft. from E. Line

_____ Ft. from W. Line

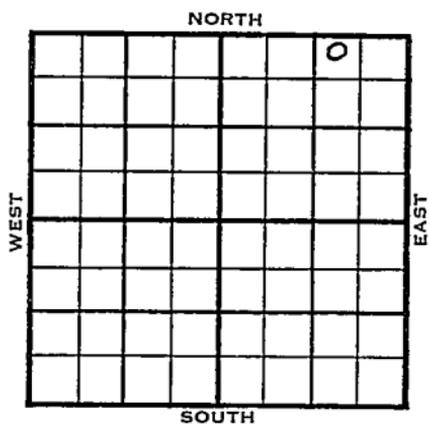

NW NE NE

1955	ELEVATION 1344	REPORT
------	-------------------	--------

6/8

Comm 5-7-55
 8" @ 337/200 DST 4599-4625 open 2 hrs.
 gas to surface in 77 min. Rec 45' sgcm
 525/20" DST 4625-55 open 2 hr. Rec. 35'
 Mud 50/20"

Tops:	Depth	Log	Datum
Tp. Elgin		3478	2134
H.		3622	2278
Tr.		3641	2297
Dg.		3671	2327
KC		4168	2824
Ce. Sd.Zn.	4552	4552	3308
M.	4596	4596	3308
TD.	4717		

D&A

FIRST REPORT



ABANDONED

County Barber ✓ Elev. 1344
 Sec. 22 Twp. 34 Rge. 11W
 Company Purcell & Mull
 Farm Name Schupback No. 1

Co.

TOPS	DEPTH	LOG	DATUM
Anh.			
Tp. <u>Elgin</u>		<u>3478</u>	<u>2134</u>
H.		<u>3622</u>	<u>2278</u>
Tr.		<u>3641</u>	<u>2297</u>
Dg.		<u>3671</u>	<u>2327</u>
BL.			
L.			
K.C.		<u>4168</u>	<u>2824</u>
B.K.C.			
Ce. <u>sd 2n</u>	<u>4552</u>	<u>4552</u>	<u>3308</u>
C.			
M.	<u>4596</u>	<u>4596</u>	<u>3252</u>
M.			
K.			
Mz.			
Mq.			
V.			
S.			
S.			
A.			
R.			
PE.			
G.			
TD.	<u>4717</u>		

Loc. in Sec. NW NE NE

Geol. _____

Contr. _____

Pool _____

Wildcat

FIRST REPORT
ABANDONED

Use.

No.

Date Comm. 5-7-55 JUN 8 1955

8" @ 337/200 DST 4599-4625 open 2 hr.

gas to surface in 77 min. Rec. 45' sgcm

525/20" DST 4625-55 open 2 hr.

Rec. 35' mud 50/20"

D & A

Sec.

T.

R.