


Section 22 Township 34 Range 26W

Well No. #1 Taylor

Company Skelly Oil & Aladdin Pet

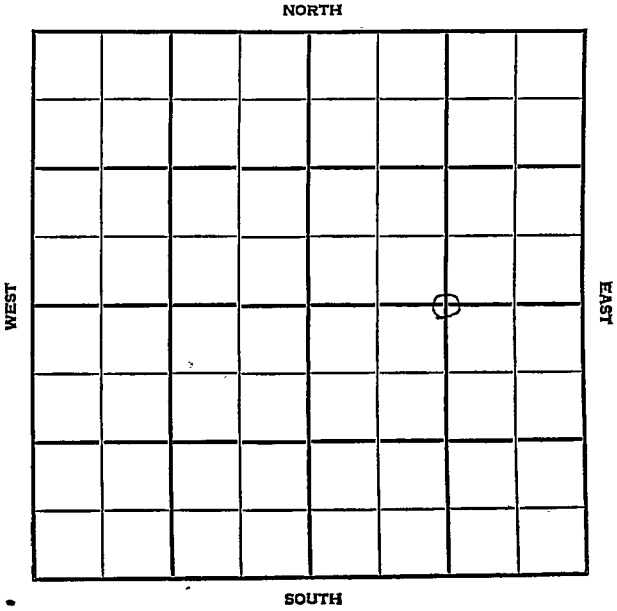

Meade

KANSAS

SEC.

22

TWP.

34

R.

26W

WELL NO.

#1 Taylor

FARM

COMPANY

Skelly Oil & Aladdin Petr.


CONTRACTOR

_____ FT. FROM N. LINE

_____ FT. FROM S. LINE

_____ FT. FROM E. LINE

_____ FT. FROM W. LINE

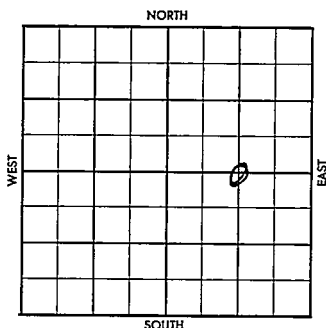C E $\frac{1}{2}$ Sec.

1956

ELEVATION

/ REPORT

8-22

Loc.

County Moade Elev. _____
 Sec. 22 Twp. 34 Rge. 26W
 Company SKelly Oil & Aladdin Pet.
 FarmName Taylor No. 1

TOPS	DEPTH	LOG	DATUM	Loc. in Sec.
Anh.				<u>C E$\frac{1}{2}$ Sec.</u>
Tr.				
H.				
Tr.				
Dg.				
Bl.				
L.				Geol. _____
K.C.				Contr. _____
B.K.C.				
Ce.				
C.				
M.				Pool _____
M.				
K.				
Mz.				
Me.				
V.				
S.				
S.				
A.				
R.				
Pe.				
G.				
T.D.				

FIRST REPORT

AUG 22 1966

Date Comm. _____

Location _____

R. G.

Co.

County Meade Elev. _____
 Sec. 22 Twp. 34 Rge. 26W
 Company Shelly Oil & Aladdin Pet.
 Farm Name Taylor No. 1

TOPS	DEPTH	LOG	DATUM	Loc. in Sec.
Anb.				C E ³ / ₈ Sec.
Tr.				
H.		3544		
Tr.				
Dg.				
Bl.				
L.	4707	4710		Geol. _____
K.C. <u>Martin</u>	5375	5404		Contr. _____
B.K.C.				
Ce. <u>L1</u>	5602	5614		Pool _____
C. <u>MW sh</u>	5896	5896		
M. <u>chest</u>	5960	5984		
M.				
K.				
Mz.				
Me.				
V.				
S.				
S.				
A.				
R.				
PE.				
G.				
T.D.	6074			

COMPLETE
 OCT 24 '56

Lse.

No.

Sec.

T.

R.

Date Comm.

Location AUG 29 '56 P 25-56
17400 SEP 5 '56 8 7/8 890/250
172355 SEP 12 '56 174145 SEP 19 '56
175412 SEP 26 '56 DST 5896-5954
1hr rec 20' GCM BHP 230/20
cid 5915-54 rec 35' + 556
176000 OCT 3 '56 DST 5950-6014
1hr rec 20' WCM BHP 825
DST 6010-74 1hr rec 20' M

13HP 540 5 1/2 6073/250
 60/5940 - 51 1/2 9a 22
 MCF OCT 10 '56 16/5954-58 1/2
 5945 9a 22 MCF FVAC
 9a 972 MCF 6 24 (M) OCT 17 '56 9a
 1.589 MCF CP 225 OCT 24 9a
 1.610 MCF 6 PD CP 250
 SICP 1850 #