

KANSAS

Stevens


Section 22 Township 34 Range 35WWell No. 1 BonsallCompany Cites Service Gas

Hugoton

NORTH

WEST

EAST

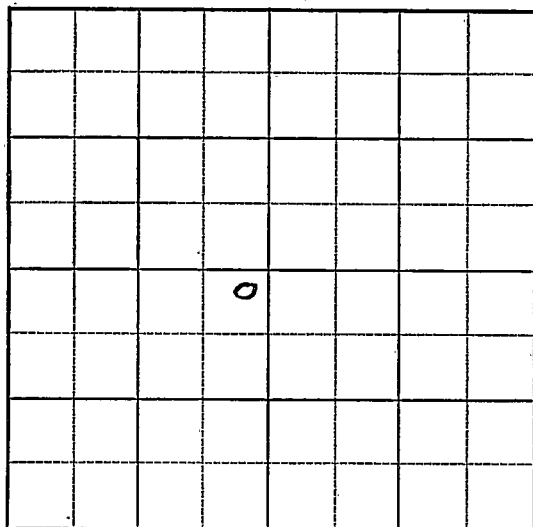

SOUTH

Sec. 22 Twp. 34 R. 35W ✓

Well No. #1 Bonsall Farm

Cities Service Gas Company


Hugoton Pool (McGill, Cont.) NORTH

150' Ft. from N. Line

 Ft. from S. Line

150' Ft. from E. Line

 Ft. from W. Line

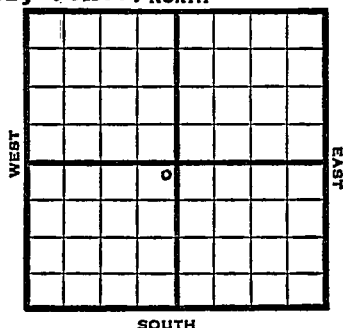

NE SW

1949	Elev. 2988' REPORT
6/15	Location
6/21	"
6/28	10" @ 746' Drlg. 2413'
7/6	TD 2672' 7" @ 2660'
7/12	TD 2805' 161' of 5" Perf liner @ 2805'
7/20	15000 acid
7/27	7" @ 2660' 161' of 5" Perf liner @ 2805' Acid 19,000 Gas 24,759,000 R. Pr. 416# TD 2805' COMPLETED

Stevens County Kansas State

Map No. _____ Sec. 22 Twp. 34 R. 35W

Well No. 1 Bonsall

Cities Service Gas Company

McGill Contractor

NE SW

**FIRST REPORT
SECTION PLAT**

150 Ft. from N. Line

_____ Ft. from S. Line

150 Ft. from E. Line

_____ Ft. from W. Line

Hugoton Pool
Remarks:

Location

Date
JUN 15 1949

Scout

S. J. LEWIS







Remains

Scout Cards	
Land Small Map	
Land Wall Map	
Tracings	
France Map	
P. e. M.	
Misc.	

Kansas

Hugoton Pool

Map No. 1 Sec. 22 Twp. 34 R. 35WWell No. 1 Bonsall

Cities Service Gas

Company

COMPLETE

Contractor

NE SW


SECTION PLAT

150 Ft. from N. Line

Ft. from S. Line

150 Ft. from E. Line

Ft. from W. Line

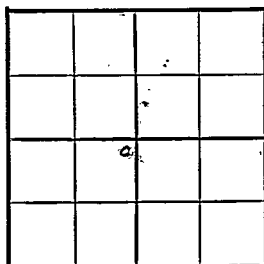

Stevens County

Location

Rig up

Drilling and Remarks:


Cased _____ in., _____ ft.

Sand _____

Gas _____

Oil _____

Total Depth 2805**PRODUCTION**

1st 24 hrs. Nat. _____

1st 24 hrs. after shot _____

Gas 24 Cu. Ft.

Dry Hole _____

Abandoned _____

Date

JUL 27 1949

19

S. J. LEWIS

Scout

Scout Cards
Land Small Map
Land Wall Map
Tracings
France Map
Pierce Map
Misc.