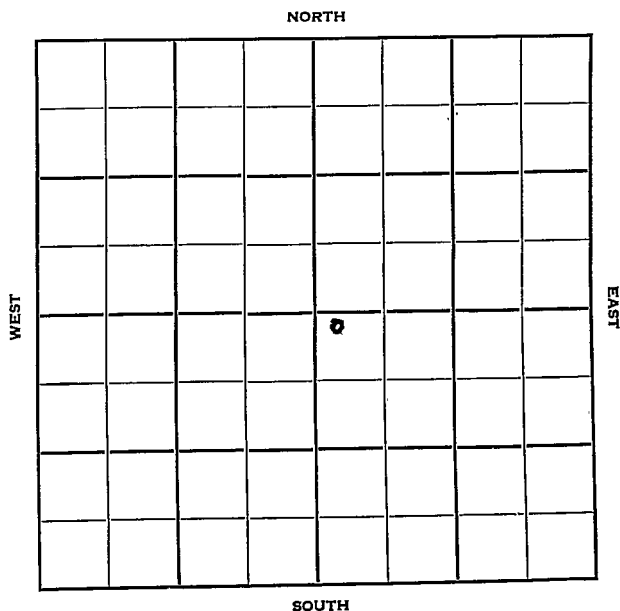


Section 22 Township 34 Range 41WWell No. #1 Stanford "B"Company Cities Service Oil

Morton

KANSAS ✓

Sec. 22 Twp. 34 R. 41W

Well No. #1 Stanford "B" Farm

Cities Service Oil

Company

Hugoton Pool

Contractor

100

Ft. from N. Line


Ft. from S. Line

Ft. from E. Line

225

Ft. from W. Line

NW NW SE

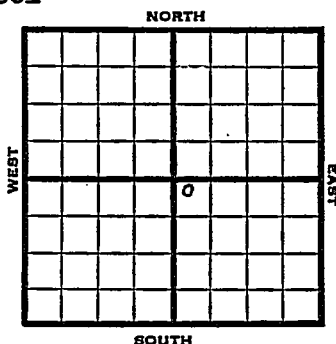

1952

Elev. 3444' REPORT

10/8

Spud 10-3-52

8" @ 360'

Drlg. 1695'

10/15

TD 2270'

5" @ 2369'

10/22

No report

10/29

CO 2388 40/2328-36, 50/2314-24 4500A

70/2278-98, 20/2272-76, 60/2254-66

12,000A

11/5

NR

11/12

Spud 10-3-52

Gas Well

TD 2338'

8" @ 360

Kri. 2255, Win. 2328'

TD 2338

40/2328-36, 50/2314-24, 70/

2278-98, 20/2272-76, 60/2254-66

12000A

Comp. 3,790,000 gas

COMPLETED

J. G. McGEHEE

J. G. McGEHEE