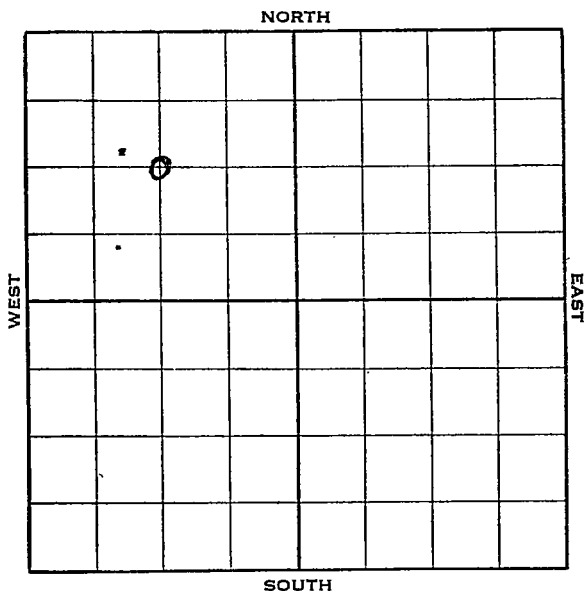


Stevens

KANSAS

Section 22 Township 34 Range 38-WWell No. 1 BurrowsCompany Kuhn Bros.

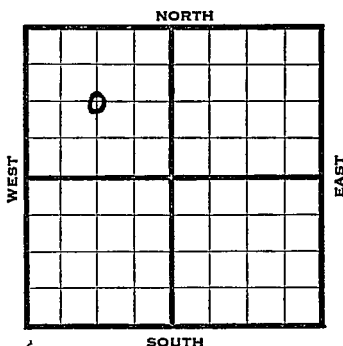
KANSAS

Stevens

Sec. 22 Twp. 34 R. 38-WWell No. #1 Burrows Farm
Kuhn Bros. Company1320 Ft. from N. Line

Ft. from S. Line

Ft. from E. Line

1320 Ft. from W. Line

1938	REPORT
4/27	Skidding rig.
5/6	S. H.
5/12	10" @ 600'.
	Drlg. 1485'.
5/20	" "
5/27	7" @ 2560'. WOC.
6/3	Drlg. 2670' S. G.
6/10	Drlg. 2770'.
6/17	T.D. 2895'. 2 M gas.
	10,000 acid.
6/22	7" @ 2560'.
	Sand ?
	T..D. 2895'.
	10,000 acid.
	6½ M gas.
	COMPLETED

Map No. WM Sec. 22 Twp. 34 R. 38WWell No. 1 BurrowsKuhn Bros.

Company

FIRST REPORT Contractor

SECTION PLAT

○			

C NW

1320 Ft. from N. Line

_____ Ft. from S. Line

_____ Ft. from E. Line

1320 Ft. from W. Line

Location _____

Rig up _____

Drilling and Remarks:

Skidding Rig.

RECORD

Cased _____ in., _____ ft.

Sand _____

Gas _____

Oil _____

Total Depth _____

PRODUCTION

1st 24 hrs. Nat. _____

1st 24 hrs. after shot _____

Gas _____ Cu. Ft.

Dry Hole _____

Abandoned _____

Date

APR 27 1938

19

H. D. Hatfield Scout

Stevens KANSAS

Map No. MM Sec. 22 Twp. 34 R. 38WWell No. 1 BurrowsKuhn Bros.

Company

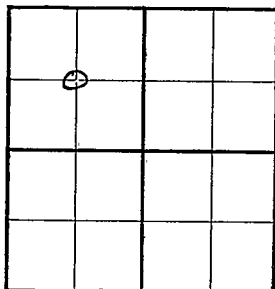
Contractor

• **COMPLETED**

C NW

1320 Ft. from N. Line Ft. from S. Line Ft. from E. Line1320 Ft. from W. Line

SECTION PLAT

Location Rig up

Drilling and Remarks:

10,000 acid
6 1/2 M gals

RECORD

Cased 7 in., 2560 ft.Sand ?Gas Oil Total Depth 2895

PRODUCTION

1st 24 hrs. Nat. 1st 24 hrs. after shot Gas Cu. Ft.Dry Hole Abandoned

Date

JUN 22 1938

19

H. D. Hatfield Scout