


Section 23 Township 34 Range 5W

Well No. #1 Lohmow Schen Heirs

Company Texas Co.

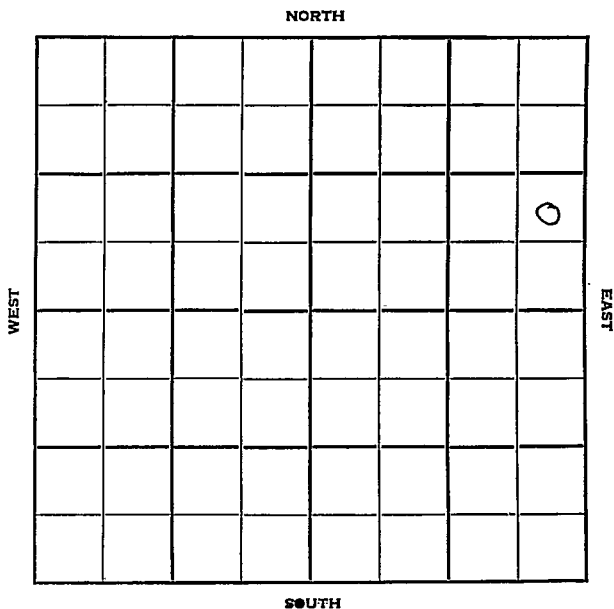

Harper

KANSAS

Sec. 23 Twp. 34 R. 5 W

Well No. # 1 Lehnor Heirs Farm

Texas Co.

Company

Stickle

Contractor

Wildcat

Ft. from N. Line

990


Ft. from S. Line

330

Ft. from E. Line

Ft. from W. Line

NE SE NE

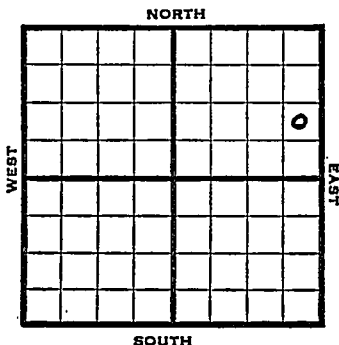

1952 Elev. 1232' REPORT


8/6 Spud 8-2-52
10" @ 549'
Drlg. 960'

8/13 Drlg. 3585'


8/20 Lay 3760 KC 3779
DST 3780-3801 1½ hr. 165' SW 1500#
DST 3849-81 1½ hr. 310' SW 1560#
DST 3925-48 1 hr. 10' M
DST 3966-85 2 hrs. 22' M & SSO 300'
gas
DST 3979-99 1 hr. 8' M TD 4020
D&A

8/27 Spud 8-2-52
D&A TD 4020' 10" @ 549' $\begin{matrix} 3779 \\ 1232 \\ 2547 \end{matrix}$
Layton 3760 KC 3779
DST 3780-3801 open 1½ hr. rec. 165'
sw 1500#
DST 3849-81 open 1½ hr. rec. 310'
SW 1560#
DST 3925-48 open 1 hr. rec. 10' mud
50#
DST 3966-75 open 2 hr. rec. 22' mud
& SSO 300' gas 85#
DST 3979-99 open 1 hr. rec. 8' mud
85# TD 4020
DST 3998-4020 open 1 hr. rec. 25' mud
85# D&A

ABANDONED

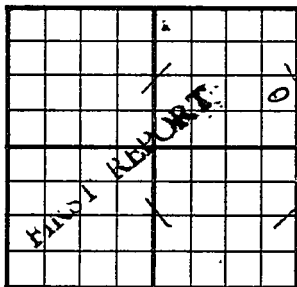County Harper State KansasSec. 23 (Blk. 34) (Sur. 5W) Map No. 5WOperator Texas Co.Well No. 1 Farm Lohom HeirsElev. Location NE SE NE990 Ft. From S Line NE330 Ft. From E Line Quarter1st. Report AUG 6 1952Completion Remarks Stickle - Contr.Spudding Date 8-2-52Drlg. Data Wildcat10" @ 549 Drlg. 960

J. G. McGEHEE

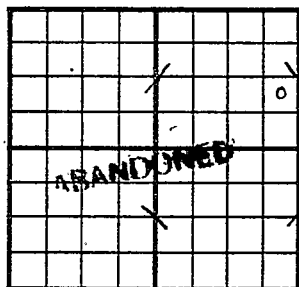County Harper State KansasSec. 23 (Blk. Twp.) 34 (Sur. Rge.) 5W Map No.Operator Texas CompanyWell No. 1 Farm Lehman HeirsElev. 1232 Location NE SE NE990 Ft. From S Line NE330 Ft. From E Line Quarter1st. ReportCompletion AUG 27 1952Remarks WildcatStickle - Contr.Spudding Date 8-2-52Drlg. Data D & A TD 402010" @ 549 Layton 3760 KC 3779DST 3780-3801 open 1½ hr. Rec. 165' sw1500# DST 3849-81 open 1½ hr. Rec.310' sw 1560# DST 3925-48 open 1 hr.Rec. 10' mud 50# DST 3966-75 open2 hr. Rec. 22' mud & SS0 300' gas85# DST 3979-99 open 1 hr. Rec.8' mud 85# TD 4020 DST 3998-4020open 1 hr. Rec. 25' mud 85#D & A