



Map No. KANSAS Sec. 23 Twp. 34 R. 2 E.


Well No. 1 Crane Farm  
Lew Hertz Company

990 Ft. from N. Line

\_\_\_\_\_ Ft. from S. Line

330 Ft. from E. Line

\_\_\_\_\_ Ft. from W. Line

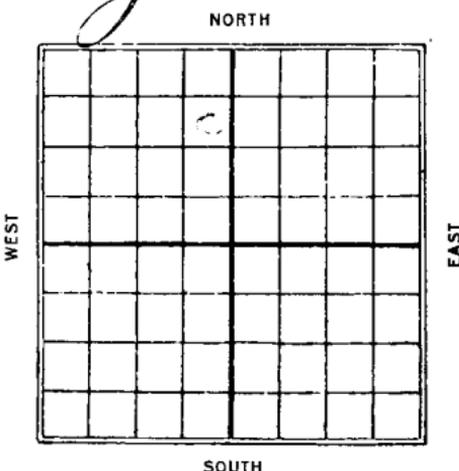

1925

Date REPORT

Date	REPORT
<u>4/25</u>	<u>Location</u>
<u>5/2</u>	<u>moving in rig</u>
<u>5/9</u>	<u>Bldg rig -</u>
<u>5/16</u>	<u>Rig - waiting out tools -</u>
<u>7/23</u>	<u>Rigging up -</u>
<u>5/31</u>	<u>Drlg - 750</u>
<u>6/6</u>	<u>" 1700</u>
<u>6/13</u>	<u>" 2450</u>
<u>6/20</u>	<u>" 3955</u>
<u>6/27</u>	<u>" 4170</u>
<u>7/3</u>	<u>8" - 4166 - rig up cable tool</u>
<u>7/11</u>	<u>T.D. 4166 Rig up</u>
<u>7/18</u>	<u>Top line 4080 - drlg 4230 -</u>
<u>7/18</u>	<u>Drlg 4280 -</u>
<u>8/1</u>	<u>" 4416 in line -</u>
<u>8/7</u>	<u>Base line 4416 - cement 6' 448</u> <u>will core drill sand</u>
<u>8/20</u>	<u>Top Wilcox 4491</u> <u>show oil 4492-93</u> <u>water 4496-99</u> <u>500 fluid in 1/2 hr</u> <u>mostly water - S.D. orders</u>

8/22 Top Wellcut 4491  
oil 4492-93  
Water 4496-99  
Dry 4501 by line  
9/5 - Dry 4506  
9/12 - T.D. - 4506  
dry. out lead plug.  
9/19 - Dry 4530'  
9/26 " 4605'  
10/3 " 4695'  
10/10 " 4770'  
10/17 - Dry & Aband - 4805'

Map No. MO 23 / Sec. 23 Twp. 34 R. 2W

Well No. 1 Corbine

Lero Kentz Company

Contractor

**SECTION PLAT**

	o		

990 Ft. from N. Line

----- Ft. from S. Line

330 Ft. from E. Line

----- Ft. from W. Line

**FIRST REPORTS**

Location ✓

Rig up -----

Drilling and Remarks:

**RECORD**

Cased ----- in., ----- ft.

Sand -----

Gas -----

Oil -----

Total Depth -----

**PRODUCTION**

1st 24 hrs. Nat. -----

1st 24 hrs. after shot -----

Gas ----- Cu. Ft.

Dry Hole -----

Abandoned -----

Date

APR 25 1928

S. J. LEWIS Scout

Map No. KANSAS Sec. 23 Twp. 24 R. 2W

Well No. 1 Crane

Sewerly Company

Contractor

**SECTION PLAT**

990 Ft. from N. Line

----- Ft. from S. Line

330 Ft. from E. Line

----- Ft. from W. Line

	o		

Correction

Location -----

Rig up -----

Drilling and Remarks:

*Reported this  
as Cozine year  
should be  
Crane.*

**RECORD**

Cased ----- in., ----- ft.

Sand -----

Gas -----

Oil -----

Total Depth -----

**PRODUCTION**

1st 24 hrs. Nat. -----

1st 24 hrs. after shot -----

Gas ----- Cu. Ft.

Dry Hole -----

Abandoned -----

Date

MAY 16 1928  
----- 192

S. J. LEWIS Scout

*Oilman*  
*No casing*  
MAP No. **KANSAS** SEC. 23 TWP. 34 R. 2W

WELL No. 1 Crane

Lew Hart COMPANY

CONTRACTOR

**SECTION PLAT**

	0		

990 FT. FROM N. LINE

FT. FROM S. LINE

330 FT. FROM E. LINE

FT. FROM W. LINE

**ABANDONED**

LOCATION \_\_\_\_\_

RIG UP \_\_\_\_\_

DRILLING AND REMARKS:

*IIA*

**RECORD**

CASED \_\_\_\_\_ IN. \_\_\_\_\_ FT.

SAND \_\_\_\_\_

GAS \_\_\_\_\_

OIL \_\_\_\_\_

TOTAL DEPTH. 4805

**PRODUCTION**

1ST 24 HRS. NAT. \_\_\_\_\_

1ST 24 HRS. AFTER SHOT \_\_\_\_\_

GAS \_\_\_\_\_ CU. FT.

DRY HOLE \_\_\_\_\_

ABANDONED \_\_\_\_\_

DATE

OCT 17 1928

SCOUT