


KANSAS

FORM 51

Clark

Section 23 Township 34 Range 25WWell No. 1 ~~Jennie~~ TheisCompany Graham Michaelis
Peters, Writer & Christianson

NORTH

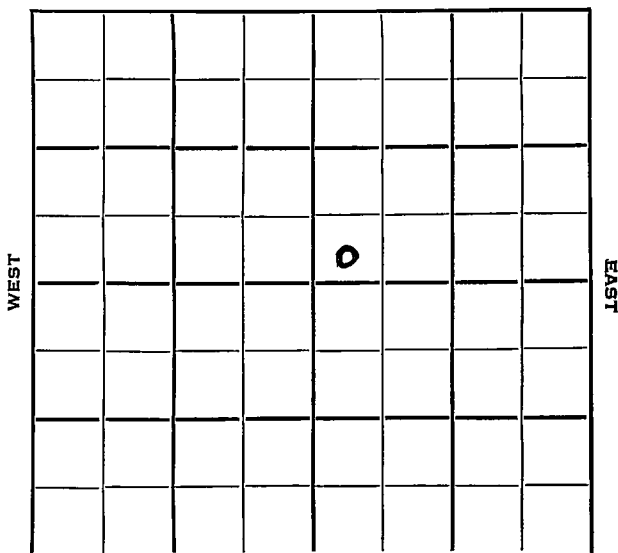

SOUTH

Clark

KANSAS



Sec. 23 Twp. 34 R. 25 W

Well No. # 1 Jennie Theis Farm

Peters, Writer & Christianson Company

Contractor

Wildcat

Ft. from N. Line


330 Ft. from S. Line

Ft. from E. Line

330 Ft. from W. Line

SW SW NE

Skelly \$12,000

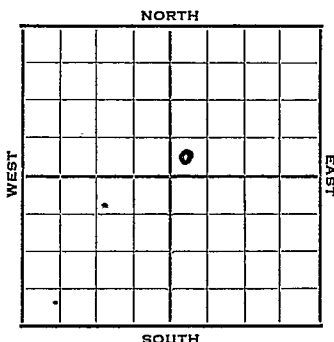

1952	Elev. 2034' IS REPORT 2039' RE
11/26	Spud 11-22-52 13" @ 640'
12/4	Drlg. 3005'
12/11	DST 2441-2575 1 Hr. 450' Misw 760# Heeb 4145 Lans 4365 Ø4533
12/18	Morm 5023 Cherokee 5198 Ø5240
12/25	" " " "
1/1	Morrow 5626 Chester 5655 DST 5660-89 1 Hr. 96' GCM 630# DST 5689-5740 1 1/4 Hr. 1180' gas 180' g & CM Drlg. 5765
1/8	DST 5739-70 22mins 10' M 1185# RTD 6113 5" @ 5830 St. Gen 6058
1/22	CO, testing
1/29	Testing
2/5	"
2/12	"
2/19	"
2/26	Testing
3/12	"

OVER

1953
3/18

Spud 11-22-52 Gas well TD 6113'
13" @ 640
DST 2441-2575 open 1 hr. rec 450'
MCSW. 760# Heeb 4338' Tor. 4365'
Lans. 4513 Marm 5167 Cherokee 5356
Morrow 5626' Chester 5655'
DST 5660-89 open 1 hr. rec 96' GCM
630#
DST 5689-5740 open 1 $\frac{1}{4}$ hr. rec 1180'
gas, 180' gas & dist. CM 130#
DST 5739-70 open 22 min rec 10' mud
1185# TD 6113' 5" @ 5830
St. Gen. 6058' 44/5744-56 500 A
1500 A 3000 A SP 5736' 32/5712-20
32/5724-32 500 A 4500 A 20 bbl
dist & gas. Perf 5692-5705 PB 5706
Perf 5693-5705' 500 A 4500 A
SP 5687 60/5670-85 GO to 5769
3 MCFG by heads 3000 A 8 MCFG
Comp. 5 $\frac{1}{2}$ MCFGPD

COMPLETED

Scout Cards *mm*

Land Small Map

Land Wall Map

Tracings

France Map


Pierce Map

Misc.

NOV 28 1952

Orig. Data

County Clark State Kansas
 Sec. 23 (Blk.) 34 (Sur.) 25W Map No.
 Operator Peters, Writer & Christianson
 Well No. 1 Farm Jennie Theis
 Elev. 2034 LS
2030 RB Location SW SW NE

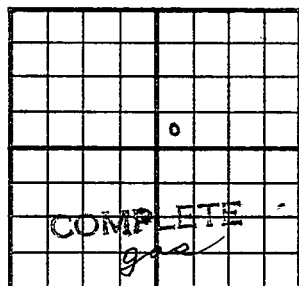

330 Ft. From S Line NE
330 Ft. From W Line Quarter
 Ist. Report
 Completion MAR 18 1953
 Remarks Wildcat

Spudding Date 11-22-52
 Drilg. Data Gas well TD 6113

13" @ 640 DST 2441-2575 open 1 hr.
Rec. 450' mcsw 760# Heeb. 4338
Tor. 4365 Lans. 4513 Marm. 5167
Cherokee 5356 Morrow 5626 Chester 5655
DST 5660-89 open 1 hr. Rec. 96' gcm
630# DST 5689-5740 open 1 $\frac{1}{4}$ hr. Rec.
1180' gas 180' gas & dist cm 130#
DST 5739-70 open 22 min. Rec. 10' mud
1185# TD 6113 5" @ 5830 St. Gen. 6058
44/ 5744-56 500 A 1500 A 3000 A
SP 5736 32/ 5712-20 32/ 5724-32 500 A
4500 A 20 blt. dist & gas Perf. 5692-
5705 PB 5706 Perf. 5693-5705 500 A
4500 A SP 5687 60/ 5670-85 CO to 5769

J. G. McGEHEE

Scout Cards	<i>mm</i>
Land Small Map	
Land Wall Map	<i>3</i>
Tracings	
France Map	
Pierce Map	
Misc.	

MAR 24 1953

Comp. 5 1/2 mfg

3 mfg by heads, 3000 A 8 mfg

Drig. Data

Co.

Use:

13" @ 640/600, 5" @ 5830/200, PB 5769,
60/5670-85, 48/5693-5705, 32/5712-20,
32/5724-32, 44/5744-56, COMPLETE 3/17/53,
12 hr blow down Ga 5, 500 MCFGD
New Info. RUGT 28/5639-46, 500 MA no help
1000A.

24

No.

2006

2

by

~~COWO~~

County Clark Elev. 2034 DF
 Sec. 23 Twp. 34 Rge. 25W
 Company Graham Michaelis
 Farm Name Theis No. 1

TOPS	DEPTH	LOG	DATUM	Loc. in Sec.
Anh.				SW SW NE
Tr.				(O.W.W.O.)
H.				
Tr.				
Dg.				
Bl.				
L.				
K.C.				Geol.
BKE				Contr.
Ce.				
C.				
Mw. Sh	5625			
M. Mw. Im	5637			Pool
K.				McKinney
Mz. Chstr	5655			
Ma.				
V. St. Gen	6058			
S.				
S.				COMPLETE
A.				
R.				
Pf.				
G.				
TD. OTD	6113			MAR 13 '57

Date Comm.

13" @ 640/600, 5" @ 5830/200, PB 5769,
 60/5670-85, 48/5693-5705, 32/5712-20,
 32/5724-32, 44/5744-56, COMPLETE 3/17/53,
 12 hr blow down Ga 5,500 MCFGD

New Info. RUCT 28/5639-46, 500 MA no help
 1000A. MAR 13 '57 G 5,500 hct from
 6/d 2000

O.W.W.O.

FORM 513 SUNRAY

County Clark Elev. 2034 DF
 Sec. 23 Twp. 34 Rge. 25W
 Company Graham-Michaelis
 Farm Name J. Theis No. 1

TOPS	DEPTH	LOG	DATUM	Loc. in Sec.
Anh.				SW SW NE
Tr.				(O.W.W.O.)
H.				
Tr.				
Dg.				
Bl.				
L. <u>marm</u>	<u>5178</u>			Geol. _____
K.C.				Contr. _____
B.K.C. <u>cherk</u>	<u>5358</u>			
Ce.				
C. <u>cherk sd</u>	<u>5610</u>			Pool _____
M.	<u>5655</u>			<u>McKinney</u>
M.				
K.				
Mz.				
Me.				
V.				
S.				
S.				
A.				
R.				
Pe.				
G.				
T.D. <u>OTD</u>	<u>6113</u>			APR 17 '57 0 FIRST REPORT

Date Comm. _____

COMPLETE

Was Miss gas well

New Info. - Pulled tubing, 1000A,

ga. 500,000 cfcpd, PB 5655, Perf 5639-46,

500 MAC, 1000AC, ga. 4,000,000 cfcpd

COMPLETE from Cherokee, sd 5639-46.

24