


Summer
 Map No. **KANSAS** Sec. *23* Twp. *34* R. *2W*
 Well No. *2-22 Douglas* Farm
Gypsum Oil Company
 NORTH

WEST

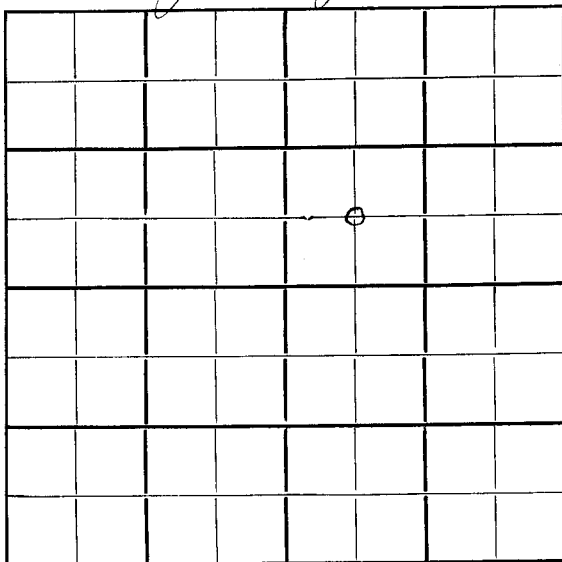

EAST

SOUTH

Location.....

Drilling Remarks

.....

.....

RECORD

Cased.....in.....ft.

Sand.....

Gas.....

Oil.....

Total Depth.....

Rig Up.....

Drilling Remarks

.....

.....

PRODUCTION

1st 24 hrs. Nat.....

1st 24 hrs. after shot.....

Gas.....cu. ft.....

Dry Hole.....

Abandoned.....

Map No. KANSAS Sec. 23 Twp. 34 R. 2W

Well No. 2-J. Douglas Farm


Gypsy Oil Company

Ft. from N. Line

660 Ft. from S. Line

Ft. from E. Line

660 Ft. from W. Line

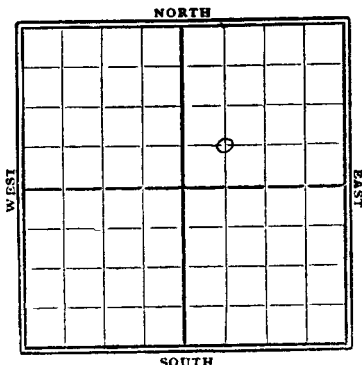

1929

Date

REPORT

5/8	Bldg Ry
5/15	
5/22	Drcy 510'
5/29	" 1510'
6/5	" 2280'
6/12	" 2975'
6/19	" 3650'
6/26	Top chat 4090' drcy
7/2	Drcy 4178' line
7/10	sem 8"-4216' crust
7/17	
7/24	Drcy 4315' line
7/29	" 4526'
8/1	Top wilcox 4528
	Small show 4537
	HFW 4545
8/7	Top chat 4090'
	Base line 4450'
	sand 4526-28' show
	Wilcox 4528-68' HFW
	TD. 4569'
	Dry & Abandoned

Map No. _____ Sec. *23* Twp. *24* R. *2W*

Well No. *31* *2 J Douglas*

G. J. J. Co. Company

Contractor

SECTION PLAT

_____ Ft. from N. Line

660 Ft. from S. Line

_____ Ft. from E. Line

660 Ft. from W. Line

		0	

FIRST REPORTS

Location _____

Rig up _____

Drilling and Remarks:

Building rig

RECORD

Cased _____ in., _____ ft.

Sand _____

Gas _____

Oil _____

Total Depth _____

PRODUCTION

1st 24 hrs. Nat. _____

1st 24 hrs. after shot _____

Gas _____ Cu. Ft.

Dry Hole _____

Abandoned _____

Date

MAY 8

1929

1929 CHAS. L. SHERWOOD

Map No. KANSAS Sec. 23 Twp. 34 R. 2ⁿ
 Well No. 2 G. Douglas
Sydney Company
 Contractor

COMPLETE

____ Ft. from N. Line

660 Ft. from S. Line

____ Ft. from E. Line

660 Ft. from W. Line

ABANDONED

SECTION PLAT

		0	

Location _____

Rig up _____

Drilling and Remarks:

Top chat 4090

Base line 4450

Sand 4576-78 Shaw

Wilcox 4578-68

JFW

RECORD

Cased _____ in., _____ ft.

Sand _____

Gas _____

Oil _____

Total Depth 4569

PRODUCTION

1st 24 hrs. Nat. _____

1st 24 hrs. after shot _____

Gas _____ Cu. Ft.

Dry Hole ☒Abandoned ☒Date
AUG 7 1929

CHAS. L. SHERWOOD

19

Scout