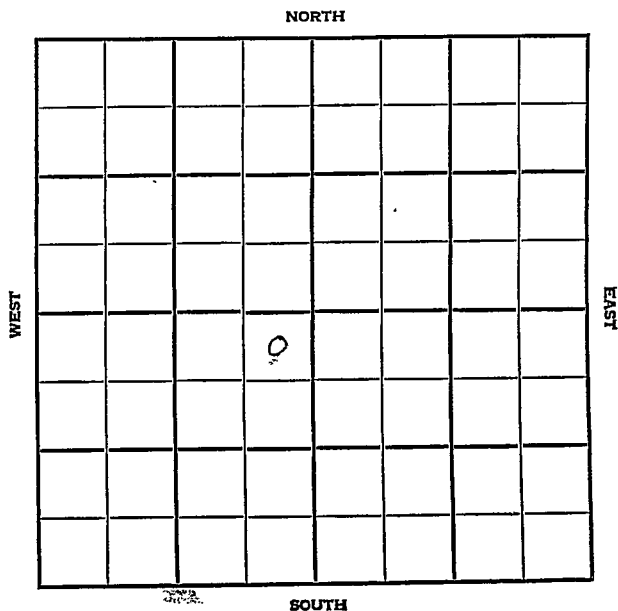


Section 23 Township 34 Range 12 WWell No. #1 Bradshaw "B"Company Cities Service

Morton

KANSAS

SEC.	TWP.	R.
23	34	42W

WELL NO. #1 Bradshaw "B" FARM

COMPANY Cities Service

CONTRACTOR Holm Drlg.
Greenwood


Ft. from N. Line

Ft. from S. Line

Ft. from E. Line

Ft. from W. Line

NE NE SW

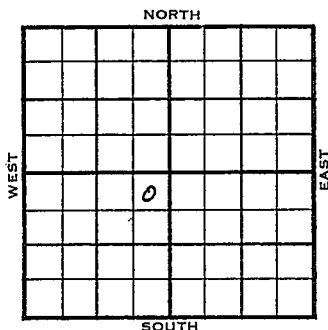

1955

ELEVATION
3481'

REPORT

10/12

Location

11-16

Comm. 10-10-55
8 5/8" @ 600/550
5 1/2" @ 3243
CO to 3205, 75/ 3181-96, 2000 A, #####
SP 3150, 40/ 3114-22, 1000 A, 1,340mcfg
SP 3100 210/ 3038-80, 5000 A, 6,400 mcfg
Comp. 14,400 mcfgpd
Tp. 2829
L. 3185
TD 3240.

COMPLETED

County Morton Elev. _____
 Sec. 23 Twp. 34 Rge. 42W
 Company Cities Service
 Farm Name Bradshaw "B" No. 1

Co.

Lse.

No.

Sec.

T.

R.

TOPS

DEPTH

LOG

DATUM

Loc. in Sec.

Anh.				NE NE SW
Tr.				
H.				
Tr.				
Dg.				
BL.				
L.				
K.C.				Geol. _____
B.K.C.				Contr. _____
Ce.				
C.				Holm Drlg.
M.				
M.				Pool _____
K.				
Mz.				Greenwood
Me.				
V.				
S.				
S.				
A.				
R.				
Pf.				
G.				
T.D.				

OCT 12 '35
 FIRST REPORT

Date Comm.

Location

[Handwritten signature]

County Morton Elev. 3481 Co. Co.
 Sec. 23 Twp. 34 Rge. 42W
 Company Cities Service
 Farm Name Bradshaw "B" No. 1

TOPS	DEPTH	LOG	DATUM	Loc. in Sec.
Anh.				NE NE SW
Tp.	2829			
H.				
Tr.				
Dg.				
Bl.				
L.	3185			Geol.
K.C.				Contr.
B.K.C.				Holm Drlg.
Ce.				Pool
C.				Greenwood
M.				COMPLETE o
M.				
K.				
Mz.				
Mq.				
V.				
S.				
S.				
A.				
R.				
Pc.				
G.				
T.D.	3240			

Date Comm. 10-10-55 NOV 16 1955

8 5/8" @ 600/550 5 1/2" @ 3243 CO to
 32 05 75/ 3181-96 2000 A SP 3150
 40/ 3114-22 1000 A 1,340 mcf/g
 SP 3100 210/ 3038-80 5000 A
 6,400 mcf/g Comp. 14,400 mcf/gd