KANSAS


Stevens County

FORM 51 5M 11-44 PETROL

Section 23 Township 34 Range 39W

Well No. #1 McAtee

Company Harrington & Marsh

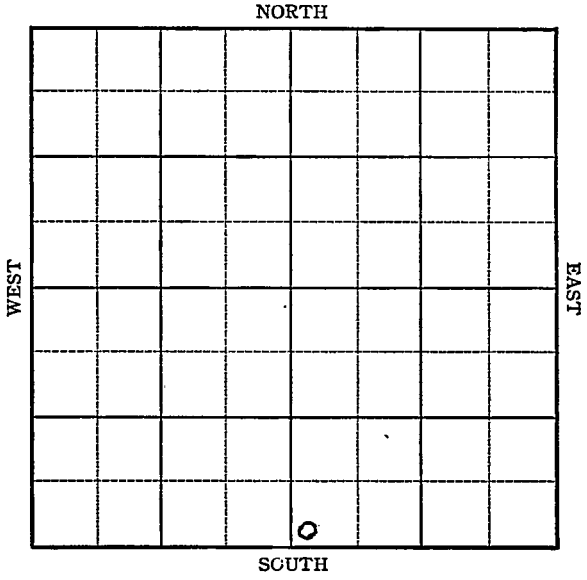

FORM 252-A
5M 8-45 PETROL

Stevens County

Sec. 23 KANSAS Twp. 34 R. 39-W

Well No. #1 McAtee Farm

Harrington & Marsh Company

Hugoton


Ft. from N. Line

140 Ft. from S. Line

Ft. from E. Line

140 Ft. from W. Line

SW SE

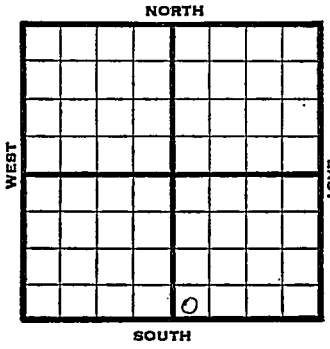

1946	3305 REPORT
6/19	Location
6/26	"
7/3	"
7/9	RUR
7/16	10" @ 600' Drlg 2504'
7/23	TD 2665 7" @ 2659' RUST
7/30	TD 2814 186' of 5" Perf liner @ 2814'
8/6	" " "
8/13	" " "
8/20	" " "
8/27	15000 acid
9/5	" "
9/10	" "
9/18	7" @ 2659' 168' of 5" Per liner @ 2814' Acid 15,000 Gas 29,500,000 TD 2814' RPR 372#

COMPLETED

FORM 26, 200 BKS. 2-44 PETROL

KANSAS

No map

Kansas Pool Name Hugoton

Map No. Sec. 23 Twp. 34 R. 39W


Well No. 1 McAtee

Harrington & Marsh Company

FIRST REPORT Contractor

SW SE

SECTION PLAT

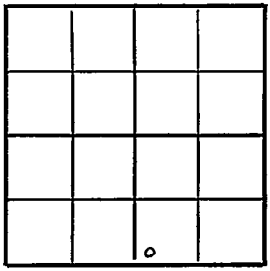

Ft. from N. Line

140 Ft. from S. Line

Ft. from E. Line

140 Ft. from W. Line

Stevens County

Location X

Rig up

Drilling and Remarks:

RECORD

Cased in., ft.

Sand

Gas

Oil

Total Depth

PRODUCTION

1st 24 hrs. Nat.

1st 24 hrs. after shot

Gas Cu. Ft.

Dry Hole

Abandoned

Date

JUN 19 1946 19

S. J. LEWIS Scout

FORM 26 200 BKS. 2-44 PETROL

KANSAS Kansas Pool Name Hugoton Pool

Map No. Sec. 23 Twp. 34 R. 39W

Well No. 1 McAtee


Harrington & Marsh Company

COMPLETED

Contractor

SW SE E 1,3205

SECTION PLAT

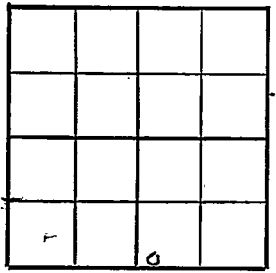

Ft. from N. Line

140 Ft. from S. Line

Ft. from E. Line

140 Ft. from W. Line

Stevens County

Location

Rig up

Drilling and Remarks:

7" @ 2655'

168' of 5" Perf liner

@ 2814

1500 gal oil

29,000,000 Gas

272# RP

RECORD

Cased in., ft.

Sand

Gas

Oil

Total Depth 2814

PRODUCTION

1st 24 hrs. Nat.

1st 24 hrs. after shot

Gas Cu. Ft.

Dry Hole

Abandoned

Date

SEP 1 8 1946 19 S. J. LEWIS Scout