

Section 24 Township 34 Range 5WWell No. #2 BakerCompany Texas Company

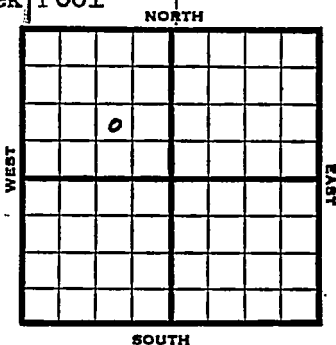
NORTH

		0					

WEST

EAST

SOUTH

Sec. 24 Twp. 34 R. 15 WWell No. # 2 Baker FarmTexas Company CompanyStickle Drlg. ContractorBluff Creek Pool Ft. from N. Line990 Ft. from S. Line990 Ft. from E. Line Ft. from W. LineNW SE NW
MCPC has SW of 19 & NW
of 30-34-14W

1953 Elev. 1221' REPORT

4/22 RUR

4/30 10" @ 65'
Drlg 2655'5/7 KC 3763
DST 3825-44, 2 hrs., 275' SW, 1525#
30"
DST 3941-53, 1½ hrs., 25' M 40#
Drlg. 4098'5/13 Spud 4-21-53 D & A TD 4119
10" @ 65 KC 3763
DST 3825-44 open 2 hr rec 275' SW
1525#
DST 3941-53 open 1½ hr. rec 25' mud
40# B KC 3997 Marm. 4079
TD 4119' D & A**ABANDONED**

County Harper State Kansas
 Sec. 24 (Blk. 34 (Sur. 5N Map No.
 (Twp.) (Rge.)
 Operator Texas Company
 Well No. 2 Farm Baker
 Elev. Location NW SE NW

FIRST REPORT

990 Ft. From S Line NW

990 Ft. From E Line Quarter

1st. Report APR 22 1953

Completion MCPC has SW of 19 &
 Remarks NW of 30-34-4N
Stickle Drig. - Contr.

Spudding Date

Drig. Data

Bluff Creek Pool

RUR

J. G. McGEHEE