
Form 51 5M 7-22 9573

Map No. _____ Sec. 24 Twp. 34 R. 6 W

Well No. 1 Mandeville Farm

Alcorn Et al Company

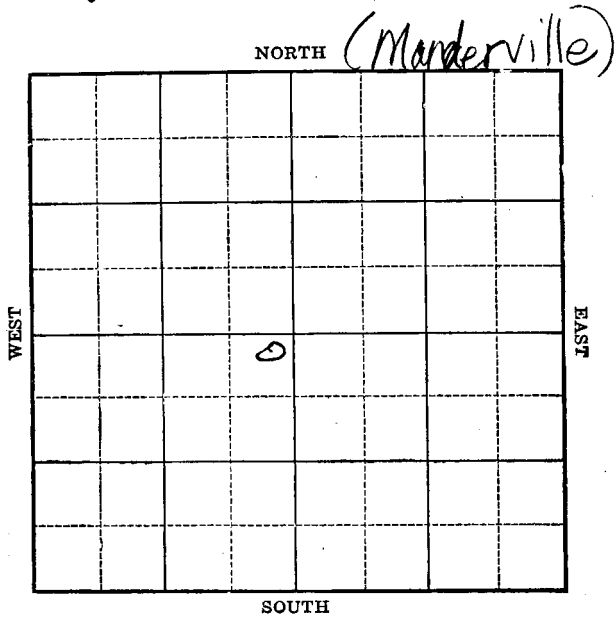

Location _____

Drilling Remarks:

Rig up _____

Drilling Remarks:

RECORD

Cased _____ in. _____ ft.

Sand _____

Gas _____

Oil _____

Total Depth _____

PRODUCTION

1st 24 hrs Nat. _____

1st 24 hrs. after shot _____

Gas _____ cu. f

Dry Hole _____

Abandoned _____

Form 252A 5M 4-22 8765

Map No. _____ Sec. 24 Twp. 34 R. 6 W

Well No. 1 Mandiville Farm


Alcorn Etal Company

200 Ft. from N. Line

_____ Ft. from S. Line

200 Ft. from E. Line

_____ Ft. from W. Line

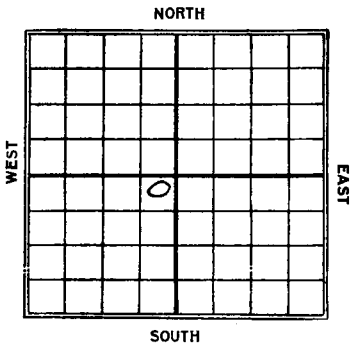

Date 4-23	REPORT
7/10	D.+A- 3775'

Map No. KANSAS Sec. 24 Twp. 34 R. [redacted]

Well No. 1 Wardwell

Gas Co. Company

Contractor

FIRST REPORT

200 Ft. from N. Line


_____ Ft. from S. Line

200 Ft. from E. Line

_____ Ft. from W. Line

ABANDONED

SECTION PLAT

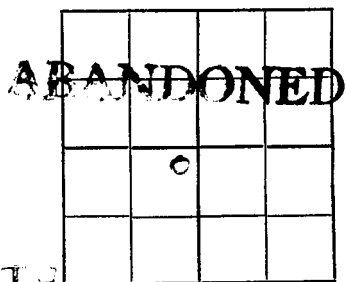

Location _____

Rig up _____

Drilling and Remarks:

2049. 3775
on roof of
fishing Jack

RECORD

Cased _____ in., _____ ft.

Sand _____

Gas _____

Oil _____

Total Depth _____

PRODUCTION

1st 24 hrs. Nat. _____

1st 24 hrs. after shot _____

Gas _____ Cu. Ft.

Dry Hole _____

Abandoned _____

Date

JUN 1 0 1923

_____ 192____

M. A. BENEAT

_____ Scout