

BARBER


KANSAS

DX 78-1

Section 24 Township 34 Range 11W

Well No. #2 Blunk

Company Adair Oil & Carter Oil

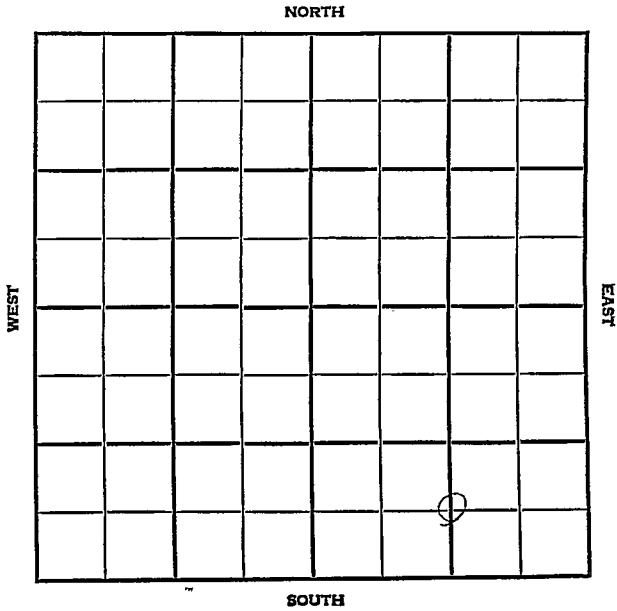

SEC. 24	TWP. 34	R. ## 14W
------------	------------	--------------

WELL NO. #2 Blunk FARM

COMPANY Adair Oil & Carter Oil

CONTRACTOR Co. Tools


Blunk

\_\_\_\_\_ FT. FROM N. LINE

\_\_\_\_\_ FT. FROM S. LINE

\_\_\_\_\_ FT. FROM E. LINE

\_\_\_\_\_ FT. FROM W. LINE

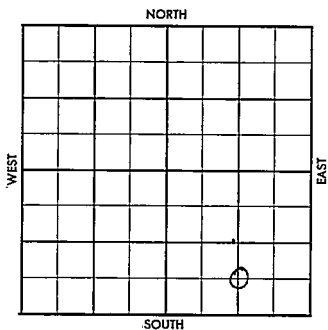

C S $\frac{1}{2}$  SE

1956	ELEVATION	REPORT
------	-----------	--------

6-13 RUR

County Barber Elev. \_\_\_\_\_  
 Sec. 21 Twp. 31 Rgs. 7W  
 Company Adair Oil & Carter Oil  
 FarmName Blunk No. 2

TOPS	DEPTH	LOG	DATUM
Anh.			
Tr.			
H.			
Tr.			
Dg.			
Bl.			
L.			
K.C.			
B.K.C.			
Ce.			
C.			
M.			
M.			
K.			
Mz.			
Me.			
V.			
S.			
S.			
A.			
R.			
PE.			
G.			
T.D.			

Loc. in Sec. G S  $\frac{1}{2}$  SE  
 Geol. \_\_\_\_\_  
 Contr. \_\_\_\_\_  
 Co. tools \_\_\_\_\_  
 Pool Blunk  
 JUN 13 '55  
**FIRST REPORT**

Date Comm. RUR

\_\_\_\_\_  
 \_\_\_\_\_  
 \_\_\_\_\_

2291 O. O. W. W.



Co.  
 Lse.  
 No.  
 Sec.  
 T.  
 R.

FORM 513 SUNRAY

County Barber Elev. 1592  
 Sec. 24 Twp. 34 Rge. 11W  
 Company Adair Oil & Carter Oil  
 Farm Name Blunk No. 2

TOPS	DEPTH	LOG	DATUM	Log. in Sec.
Anh. <u>E19</u>	<u>3733</u>	<u>3698</u>		<u>C S <math>\frac{1}{2}</math> SE</u>
Tr.				
H.	<u>3926</u>	<u>3926</u>		
Tr.	<u>3939</u>	<u>4</u>		
Dg.	<u>3996</u>	<u>4010</u>		
BL				
L.	<u>4103</u>	<u>4103</u>		
K.C.				Geol.
B.K.C.				Contr.
Ce.				
C.				Co. tools
M.	<u>D010</u>	<u>4690</u>	<u>4690</u>	<u>-3098</u>
M.				Pool
K.				<u>Blunk</u>
Mz.				
Mo.				
V.				
S.	<u>4192</u>			<b>ABANDONED</b>
S.	<u>4192</u>			
A.	<u>12066</u>			
R.	<u>109</u>			
PE.	<u>5</u>			
G.				
TD.	<u>4735</u>			

ABANDONED  
 DEC 20 '56

Date Comm. JUN 20 '56  
RUR 6-10-56 85/8 323  
1270 3552 JUN 27 '56 DST 3705  
-50 90" 2333' SW BHP 1440  
120" 4565 JUL 3 '56 DST 4689  
-4707 90" 9 in 3 1/2" 99 431  
MCF in 10" no rec. FP 100-100  
BHP 1780 130" DST 4707-35 70"  
2700' 900' net 50' md BHP 210/20  
4 1/2 4696 JUL 11 '56 JUL 18 '56 JUL 25 '56

CO 4735 TD F1AC. S.I.  
 AUG 22 '56 Flwd 1/2" ch CP 780#  
 (sit. wtr?) AUG 29 '56 ga est  
 5 Mill C.F.G.P.D. SEP 5 '56 survey  
 on wtr (was Miss wtr.) Plastic  
 to 4726 co Plastic to 4704  
 co 4735 FU with wtr. SEP 12 '56  
~~SEP 19 '56~~ SEP 19 '56 CO  
 4710 Hole in pipe S&D  
 co 4606 Re S&D. SEP 26 '56  
 Re PF 6/3050-51 OCT 3 '56  
 OCT 10 '56 OCT 17 '56 OCT 24 '56 Making est  
 1 1/2 Mill C.F.G. + Lots wtr. OCT 31 '56  
 NOV 7 '56 NOV 13 '56 NOV 21 '56 NOV 28 '56 ✓ DEC 5 '56  
 DEC 12 '56 DEC 19 '56 gas est. no good.

D & A ~~total~~

**CORRECTION**

*Corrected Info.*

FORM 513 SUNRAY

County Barber

Elev. \_\_\_\_\_

Sec. 24

Twp. 34

Rge. 14W

Company Adair & Carter Oil

Farm Name Blunk

No. 2

TOPS	DEPTH	LOG	DATUM
Anh.			
Tr.			
H.			
Tr.			
Dg.			
Bl.			
L.			
K.C.			
B.K.C.			
Ce.			
C.			
M. <u>dolo</u>	<u>4690</u>		
M.			
K.			
Mz.			
Me.			
V.			
S.			
S.			
A.			
R.			
Pe.			
G.			
T.D.			

Loc. in Sec.

C S $\frac{1}{2}$  S $\frac{1}{2}$  SE

Geol. \_\_\_\_\_

Contr. \_\_\_\_\_

Pool

Blunk

**FIRST REPORT**  
 MAR 13 1937  
**COMPLETE**

Date Comm. (CORRECTED INFORMATION)

Completed as D & A several months ago.

RTD 4735, 4" @ 4696/125, PBSD 4710 -  
 producing thru O. H. from 4696-4710, C.S.O.

Ga @ 3,341 mcfg/day, BHSIP 1622 # -

**COMPLETE**

*28*

Co.

Loc.

No.

Sec.

T.

R.