

Clark


KANSAS

SECTION 24 TOWNSHIP 34 RANGE 21W

WELL NO. #1 J.C. Harper "D"

COMPANY The Pure Oil Co.

NORTH

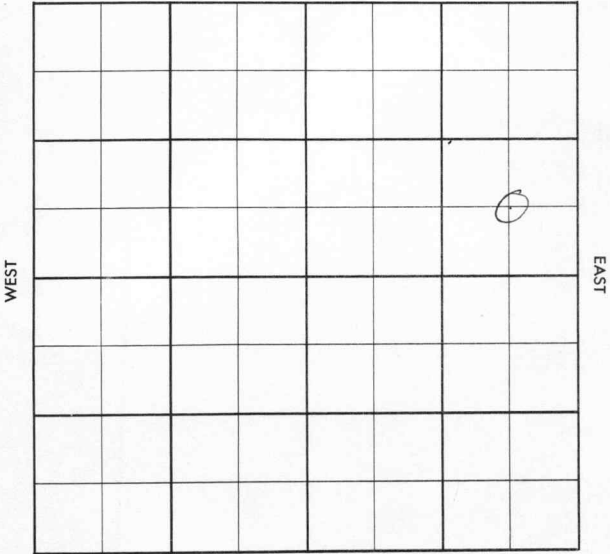

SOUTH

HOT FILE

Clark

KANSAS

SEC.

TWP.

R.

24

34 S

21 W

WELL NO.

1 J. C. Harper "D"

FARM

COMPANY

The Pure Oil Co.

CONTRACTOR


Wildcat

_____ FT. FROM N. LINE

_____ FT. FROM S. LINE

_____ FT. FROM E. LINE

_____ FT. FROM W. LINE

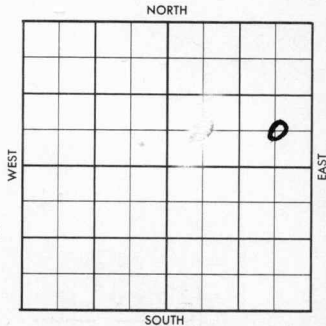~~SEXX~~ C SE NE

Aladdin & Rockhill-DHM

SDX-DHC-\$4000.00

Direct W Offset to SDX 160 acre lease

ELEVATION

1956

1820'

REPORT

(WH6-DC80)

10/3

Mississippi Test appx 5600'
 To commence by October 15, 1956
 To complete by December 1, 1956
 (See DHC agreement 10/3/56)

10/3

Location (FR Tkt)

12/13

Spud 10-5-56 Lans. 4513'
 20" @ 120/225 8-5/8" @ 592/300
 TD 5105' (14' low to Pure B-1 Harper
 and 26' low to Pure B-2 Harper)
 Mw ? 5401. Core 5404-62, rec 58'
 (2½' sh, 1½' lime + 4' light gr.
 sh, 1' tan lime, ½' lm cg & gr. sh
 5½' hard dense tan lime, 7' sh drk
 gray) + 36' dark gray sh, Miss 5512'
 Core 5462-5520, rec 58' (8' gray sh)
 3½' lght gry to tan hard dense sdy
 19, 4½' dark gray sh, 4½' dark gray
 sh w/few sd strks, 13½' sd fine white
 good poro & perm, huyst. hvy fluor,
 bleeding O & G, tr. slt wtr., 5' sh
 dark gray w/thin tight sd strks,
 4' gray li, tan to dense li, bleeding
 O & G, along bedding plane, 2' lime &
 sh, 1' tan lime, some gray w/vugut. por
 bleeding O & G, 4' gray l, bleeding
 O & G along bedding plane, 8' tan xlyn
 lime. DST failed.

OVER

1956
12/13

(Information continued)

DST 5487-5520', open 1 hr, gas 15"
TSTM, rec 1004' free oil, no wtr.
FP 155-312# BHP 2028# 20". HP 2615#
(~~XMR~~ To run induction log.) RTD 5612'
Cave in. CO 5 $\frac{1}{2}$ " @ 5610 w/325 CO 5612'
LWL PB 5566' 96/5514-5538 PB 5504'
64/5480-96 S/2-3/4 BOPH 4 hrs.
S/58 BO, no wtr. 24 hrs. Frac 10 x 5
Flowed 254 BO 8 hrs. 16/64" ck.
CP 1550# TP 1330#.
Ph.P/316 BOPD no water 22/64" ch.
CP 1500# TP 1450#
TD 5612'- Completed

COMPLETED

1-3-57 - Advised Contract Section Comp. ✓

County Clark Elev. 1820
 Sec. 24 Twp. 34S Rge. 21W
 Company The Pure Oil Co.
 Well Name J. C. Harper "D" No. 1

	DEPTH	LOG	DATUM	Loc. in Sec.
Tr.				C SE NE
Dg.				
Bl.				
L.	4513			Geol.
K.C. Mw Mw	5401			Contr.
B.K.C. MISS	5512			
Ce.				
C.				
M.				
M.				Pool
K.				Wildcat
Mz.				<div style="border: 1px solid black; padding: 5px; text-align: center;"> <p>COMPLETED</p> <p>DEC 3 1956</p> </div>
Me.				
V.				
S.				
S.				
A.				
R.				
PE.				
G.				
FD.	5612			

Date Comm. SDX, Aladdin & Rockhill - DHM

LOG. OCT 10 '56 Bldg Roads 10-5-56

20" @ 120 / 225 - 8578 592 / 300

OCT 17 '56 9102213 OCT 24 '56 5105

(14' low to pore B1 Harper and

26' low to pore B2 Harper. OCT 31 '56

X Mw? 5401 core 5404-62 rec.

58' (2 1/2' sh - 1 1/2' Lime + 4' Light gr. sh

1' Tan Lime 1/2' Lm c9 & gr. sh. 5 1/2' Hard

dense tan Lime 2' sh. drk gray) + 36'

Dark gray sh. Miss 5512 core
 5462 - 5520 nec 58' (8' gray sh)
 3 1/2' Light gray to tan hard dense sdy
 Li. 4 1/2 dark gray sh. 4 1/2' dark gray
 sh w/ few sd stks. 13 1/2' sd fine white
 good Por & Perm. Huyst. Huy Flour.
 bleeding O&G Tr. sit wtr. 5'
 sh drk gray w/ thin tight sd stks.
 4' gray Li tan to dense Li bleeding
 O&G along bedding Plane. 2' Lime
 & sh. 1' Tan Lime some gray w/ Vugol.
 Por. bleeding O&G. 4' gray L. bleeding
 O&G along bedding Plane. 8' Tan
 x/40 Lime DST Failed DST
 (5487 - ~~87~~⁵⁵²⁰) op the 9 1/5" TSTM
 nec 1004' Free oil nolw
 FP 155 - 312 BHP 2028/20" Hyd
 Press 2615 (To run induction Log)
 NOV 7 '56 X RTP 5612 cave in
 CO 5 1/2 @ 5610 / 325 NOV 13 '56 CO
 5612 LWL PB 5566 96/
 5514 - 5538 ~~5512~~^{PD 5504} 64/5480
 - 96. ♂ 2 3/4 Bopd 4 hrs
 X 58 BO nolw 24 hrs NOV 21 '56 X
 Frac 10 x 5 Flwd 254 BO 8 hrs
 1 1/4" ch CP 1550# TP 1330#
 NOV 28 '56 DEC 5 '56 DEC 12 '56

24-34-21

C se ne