


Section 24 Township 34 Range 26^W

Well No. #1 C. E. Cox

Company Skelly, Aladdin & Champlin

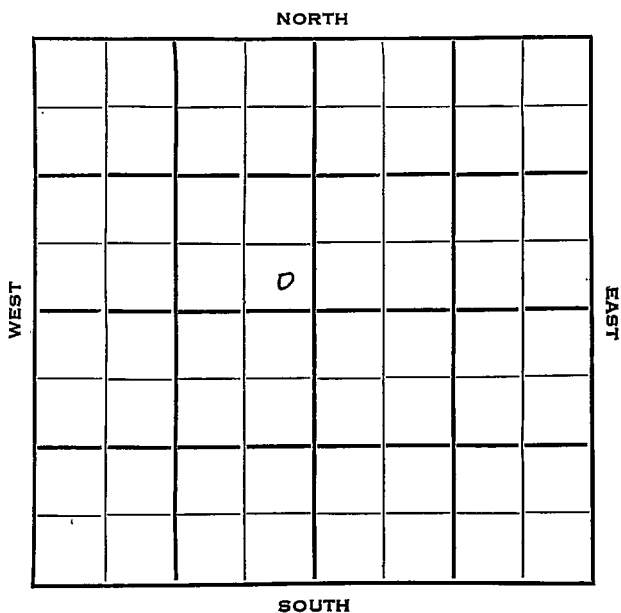

Sec. 24 Twp. 34 R. 26W

Well No. #1 C. E. Cox Farm

Skelly, Aladdin & Champlin Company

Contractor


Ft. from N. Line

330 Ft. from S. Line

330 Ft. from E. Line

Ft. from W. Line

SE SE NW

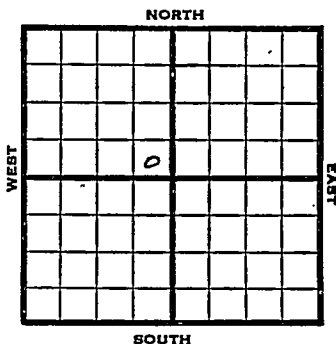

1953 Elev. 2176' REPORT

- 3/4 Location
- 3/12 Drlg. 657'
- 3/19 9" @ 1094'
Drlg. 2793'
- 3/26 Drlg. 4252'
- 4/2 Heeb 4404, Tor 4423, Lans 4575
Drlg 5137'
- 4/9 NR
- 4/16 "
- 4/23 "
- 4/30 "
- 5/7 NR
- 5/21 "
- 5/28 NR
- 7/1 NR
- 7/15 Spud 3-8-53
Gas Well
TD 5965'
9" @ 1094'
Heeb 4404, Tor 4423, Lans 4575,
Marm 5274, Cherokee 5477, Morrow
5756, Miss 5834,

OVER

1953

Information brought forward.

7/15

DST 5755-5830 opn 1 hr, rec 360' gcm
DST 5826-76 opn 55 min, rec 450' mud
TD 5965'
5" @ 5961'
DST 5876-5922' failed.
72/ 5864-76 1000 A 4000 A
PB 5842
PB 5832 72/ 5810-23 1000 A 4000 A
PB 5801
96/ 5782-98 CO to 5931
SP 5805
33/ 5787-98 st-frac B/ 2 bswph
SP 5755 CO to 5824 39/ 5810-23
SP 5804 st-frac SP 5775 S/ 8 bwph
PB 5931'
SP 5770 CO to 5872 39/ 5810-23
SP 5801 500A SP 5807 CO to 5931
36/ 5869-76 1000 A 5000 frac.
62,000 cu ft.
Comp. shut in gas well.
200,000 gas.

COMPLETED

SS

| | |
|----------------------|-------|
| Scout Cards | |
| Land Small Map | |
| Land Wail Map | |
| Tracings | |
| France Map | |
| Pierce Map | |
| Misc..... | |

MAR 6 1953

Drig. Data

36/5869-76 1000 A 5000 frac
62,000 cu ft. Comp. shut in gas well
200,000 gas

Scout Cards
Land Small Map
Land Well Map
Tracing
France Map
Pierce Map
Misc

JUL 29 1953

W. S. ...