
FORM 51 10M 8-47

KANSAS

Section 24 Township 34 Range 30W

Well No. #1-A Adams ~~#3 Adams~~

Company Helmerich & Payne

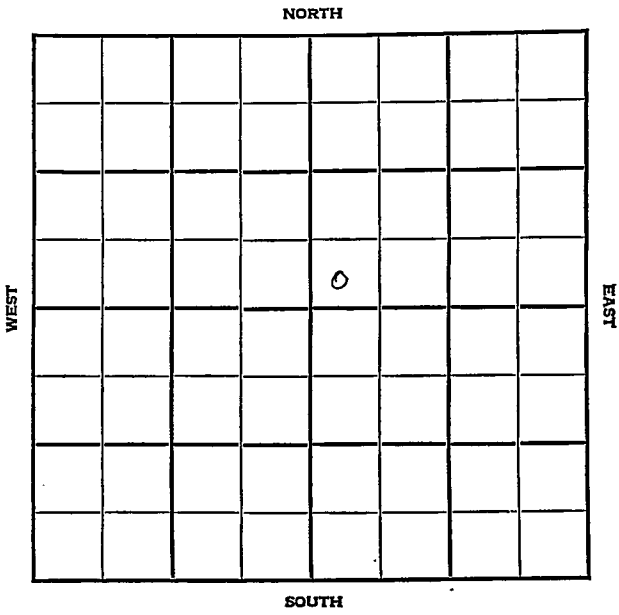

FORM 252-A
5M 9-47 PETROL

KANSAS - Meade

Sec. 24 Twp. 34 R. 30W

Well No. #1-B ~~#5~~ Adams -- Farm

Helmerich & Payne of Texas Company

Adams Pool


____ Ft. from N. Line

330' Ft. from S. Line

____ Ft. from E. Line

330' Ft. from W. Line

SW NE

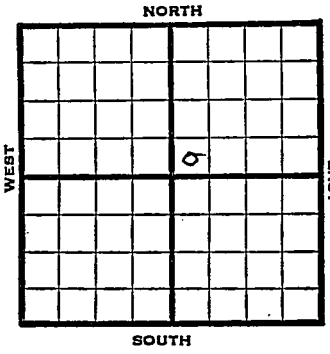

1947	Elev. 2622' REPORT
11/25	Location
12/3	"
12/10	"
12/17	RUR
12/30	13" @ 582' Drlg. 2674'
1948 1/7	TD 2900' 9-5/8" @ 2885'
1/14	Drlg 3757'
1/21	Drlg. 4720' Lansing 4602'?
1/26	Drlg 5324'
2/4	Morrow 5891' Drlg. 5918'
2/11	Mississippi 5957' TD 6300'
2/18	TD 6510' SD
2/25	7" @ 6311' RUST

(Over)

1948

3/3 Plug 6080 18 shots 6032-47
40 " 6032-50
3,141,000 Gas
Spray oil estimate 10 bbls a day
1000 acid

3/10 "

3/17 "

3/24 "

3/31 "

4/7 "

4/14 "

4/21 204 shots 5920-54 500 acid
Flow 20½ bbls oil & 5% BS&W in
24 hrs.

4/28 Miss 5957'
7" @ 6311'
Sd 6264'
Pump 24 oil & 15% W
Gas 5,200,000
TD 6510'

6264
2622
3642

COMPLETED



Form 26 200 Bks. 10-46 Petrol

Kansas

Adams Pool

Map No. _____ Sec. 24 Twp. 34 R. 5 OW


Well No. 3 Adams

Helmerich & Payne Company

FIRST REPORT Contractor

SW NE

SECTION PLAT

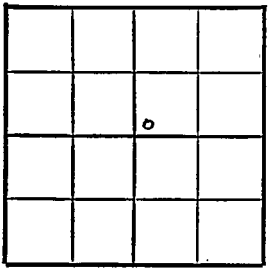

_____ Ft. from N. Line

330 Ft. from S. Line

_____ Ft. from E. Line

330 Ft. from W. Line

Meade County

Location X

Rig up _____

Drilling and Remarks:

RECORD

Cased _____ in., _____ ft.

Sand _____

Gas _____

Oil _____

Total Depth _____

PRODUCTION

1st 24 hrs. Nat. _____

1st 24 hrs. after shot _____


Gas _____ Cu. Ft.


Dry Hole _____

Abandoned _____

Date

NOV 25 1947 19 S. J. LEWIS Scout

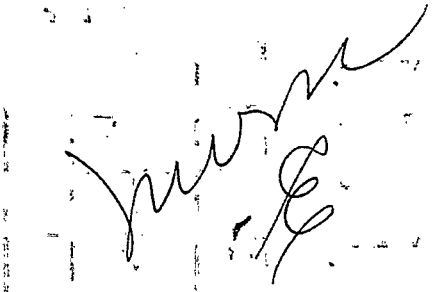

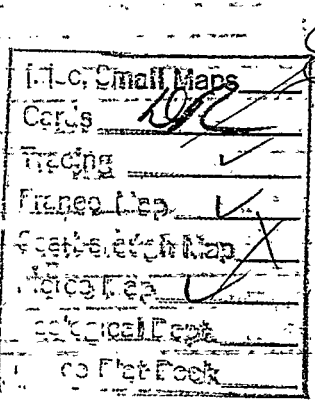
Misc. Small Maps
Cards
Tracing

Form 26 200 Bks. 10-46 Petrol

Adams Pool

Kansas

No Map

Map No. ____ Sec. 24 Twp. 34 R. 30W

Well No. 1 "A" Adams


Helmerich & Payne & Texas Company

CORRECTION

Contractor

SW NE

SECTION PLAT

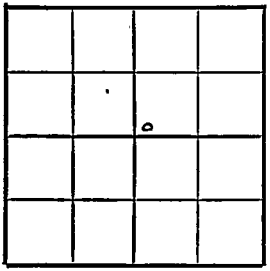

____ Ft. from N. Line

330 Ft. from S. Line

____ Ft. from E. Line

330 Ft. from W. Line

Meade County

Location

Rig up

Drilling and Remarks:

Reported as
#3 Adams

RECORD

Cased ____ in., ____ ft.

Sand

Gas

Oil

Total Depth

PRODUCTION

1st 24 hrs. Nat.

1st 24 hrs. after shot

Gas ____ Cu. Ft.


Dry Hole

Abandoned

Date

FEB 1 8 1948 19

S. J. LEWIS Scout

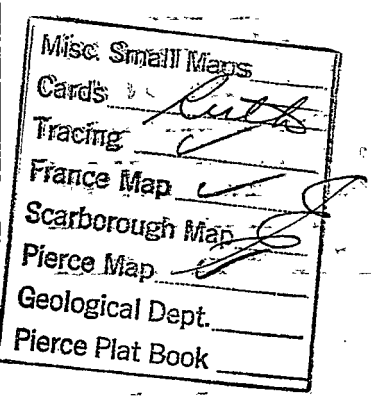
Misc. Small Maps
Cards
Tracing
France Map
Scarborough Map
Pierce Map
Geological Dept.
Pierce Plat Book

Form 26—200 Bks.—1-48—Palace

Kansas

Adams Pool

Map No. _____ Sec. 24 Twp. 34 R. 30W

Well No. 1 "A" Adams


Helmerich & Payne & Texas Company

COMPLETE Contractor

SW NE

E 12622

SECTION PLAT

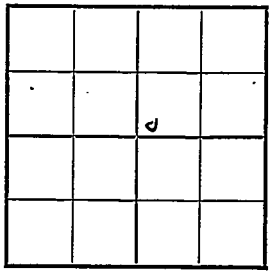

_____ Ft. from N. Line

330 Ft. from S. Line

_____ Ft. from E. Line

330 Ft. from W. Line

Meade County

Location _____

Rig up _____

Drilling and Remarks:

Miss 5957

7" C 6311

Sol 6264

Pump 240 bbls Total

5,200,000 Gas

RECORD

Cased _____ in., _____ ft.

Sand _____

Gas _____

Oil _____

Total Depth 6270

PRODUCTION

1st 24 hrs. Nat. _____

1st 24 hrs. after shot _____

Gas _____ Cu. Ft.


Dry Hole _____

Abandoned _____

Date

APR 28 1948 19

S. J. LEWIS Scout

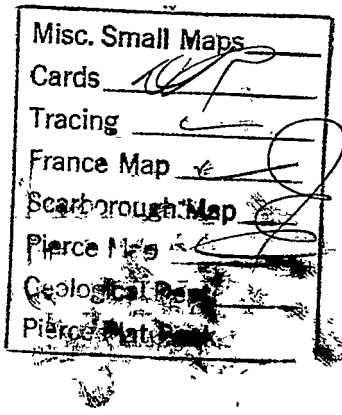
Misc. Small Maps
Cards
Tracing
France Map
Scarborough Map
Pierce Maps
Geological Papers
Pierce Plat Books