


Section 24 Township 34 Range 34W

Well No. #1 Gleeson "B"

Company Cities Service

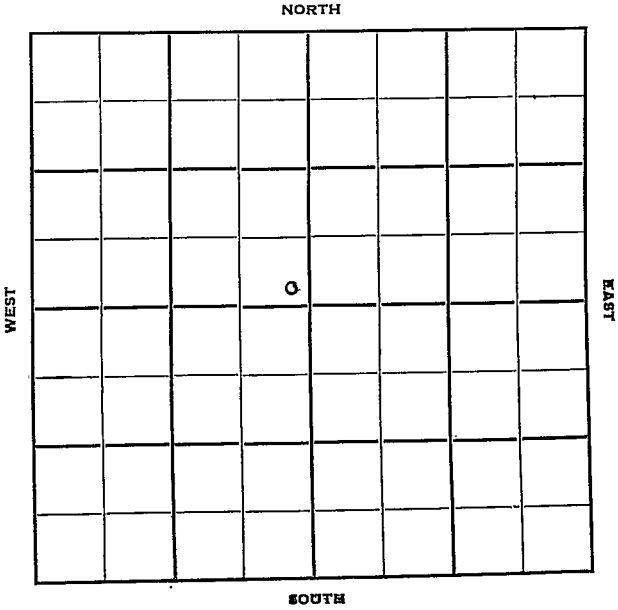

KANSAS
34

Seward

Sec. 24 Twp. 34 R. 34-W ✓

Well No. #1 Gleeson "B" Farm

Cities Service Company

Barbour Drlg. Contractor

Hugoton


_____ Ft. from N. Line

100 Ft. from S. Line

100 Ft. from E. Line

_____ Ft. from W. Line

SE NW

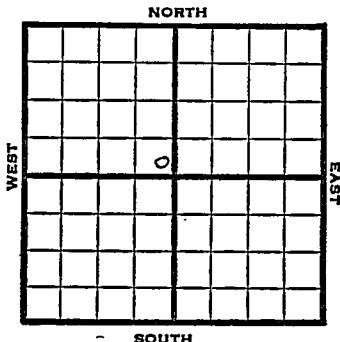

1950

Elev 2892' REPORT

10/18 Location

1951

1/10

Spud 10-17-50

8" @720

5" @ 2769

TD 2770

Her 2614

Krider 2638

Win 2722

30/2722-28 40/2706-14, 150/2670-2700

40/2640-48 40/2616-24, 30/2604-10

22000 A

Comp 12,000,000 gas 407#

Completed

COMPLETED

County **Seward** State **Kansas**

Sec. **24** (Blk. Twp.) **34** (Sur. Rge.) **3 4W** Map No.

Operator **Cities Service**

Well No. **1** Farm **Gleeson "B"**

Elev. Location **SE NW**

100 Ft. From **S** Line **NW**

100 Ft. From **E** Line **Quarter**

Ist. Report **OCT 18 1950**

Completion

Remarks

Barbour Drlg. - Contr.

Spudding Date

Drlg. Data **Hugoton Pool**

Location

OCT 25 1950

Scout Cards	70
Land Small Map	5
Land Wall Map	
Tracings	
France Map	
Pierce Map	
Misc.	

Orig. Data

County Seward State Kansas

Sec. 24 (^{Blk.} ^{Twp.}) 34 (^{Sur.} ^{Rge.}) 34W Map No.

Operator Cities Service

Well No. 1 Farm Gleeson "B"

Elev. 2892 Location SE NW

COMPLETE									

100 Ft. From S Line NW

100 Ft. From E Line Quarter

1st. Report

Completion JAN 1 0 1951

Remarks Hugoton Pool

Barbour - Contr.

Spudding Date 10-17-50

Drilg. Data Gas well TD 2770

8" @ 720 5" @ 2769 TD 2770

Her. 2614 Krider 2638 Win. 2722

30/ 2722-28 40/ 2706-14 150/ 2670-2700

40/ 2640-48 40/ 2616-24 30/ 2604-10

22000 A Comp. 12,100,000 gas 407#

J. E. TYRA

70

SCOUT CARDS
Land Survey Map
Land Wall Map
Tracings
France Map
Pierce Map
Misc.

JAN 19 1951

Orig. Data