


Section 24 Township 1 Range 34 Range 35W

Well No. #1 Hudkins

Company Cities Service

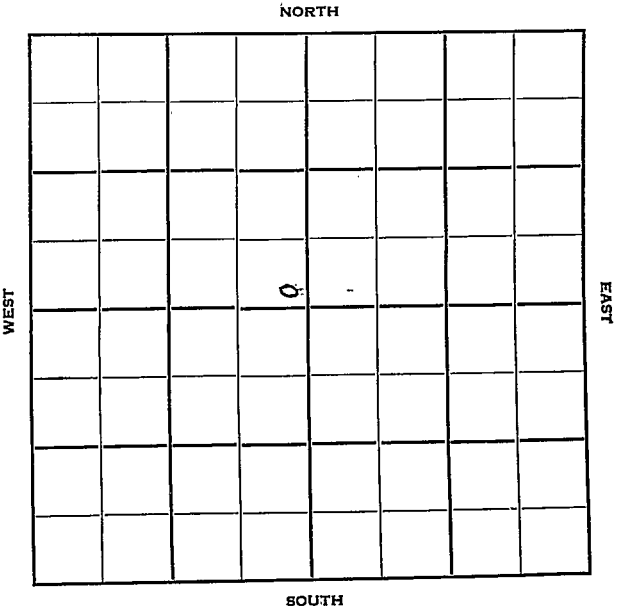

Stevens KANSAS

Sec. 24 Twp. 34 R. 35W

Well No. #1 Hudkins Farm

Cities Service

Company

Hugoton Pool

 Ft. from N. Line

100'


 Ft. from S. Line

100'

 Ft. from E. Line

 Ft. from W. Line

SE NW

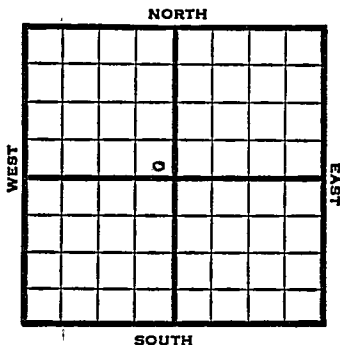

1950

Elev 2977' REPORT

1/18

Spud 1-13-50

8" @ 760'

Drilg. 1955'

2/15

T^D 2830'

8" @ 760'

5" @ 2829'

Her 2650'

Gr 2684'

17,800,000 CFGPD

Comp

COMPLETED

Kansas

Hugoton Pool

Map No. _____ Sec. 24 Twp. 34 R. 35WWell No. 1 Hudkins

_____ Cities Service _____ Company

_____ Contractor

SE NW

SECTION PLAT

_____ Ft. from N. Line

100 Ft. from S. Line100 Ft. from E. Line

_____ Ft. from W. Line

FIRST REPORT

Stevens County

Location _____

Rig up _____

Drilling and Remarks:

Spud 1-13-50

8" @ 760

drlg. 1955

RECORD

Cased _____ in., _____ ft.

Sand _____

Gas _____

Oil _____

Total Depth _____

PRODUCTION

1st 24 hrs. Nat. _____

1st 24 hrs. after shot _____

Gas _____ Cu. Ft.

Dry Hole _____

Abandoned _____

Date

JAN 18 1950

19

J. E. TYRA

Scout

Map No. _____ Sec. 24 Twp. 34 R. 35WWell No. 1 Hudkins

Cities Service

Company

Contractor


SE NW

E! 2977
SECTION FLAT

_____ Ft. from N. Line

100 Ft. from S. Line100 Ft. from E. Line

_____ Ft. from W. Line

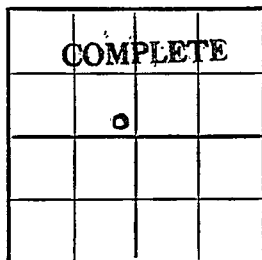

Stevens County

Location _____

Rig up _____

Drilling and Remarks:

8" @ 7605" @ 2829Rev 2650Cr. 268417,800,000C.F.G.P.D.

RECORD

Cased _____ in., _____ ft.

Sand _____

Gas _____

Oil _____

Total Depth 2830

PRODUCTION

1st 24 hrs. Nat. _____

1st 24 hrs. after shot _____

Gas _____ Cu. Ft.

Dry Hole _____

Abandoned _____

Date

FEB 15 1950

J. E. TYRA

19

Scout