


Morton

KANSAS

SECTION 24 TOWNSHIP 34 RANGE 43W

WELL NO. #1 Kansas

COMPANY Panhandle

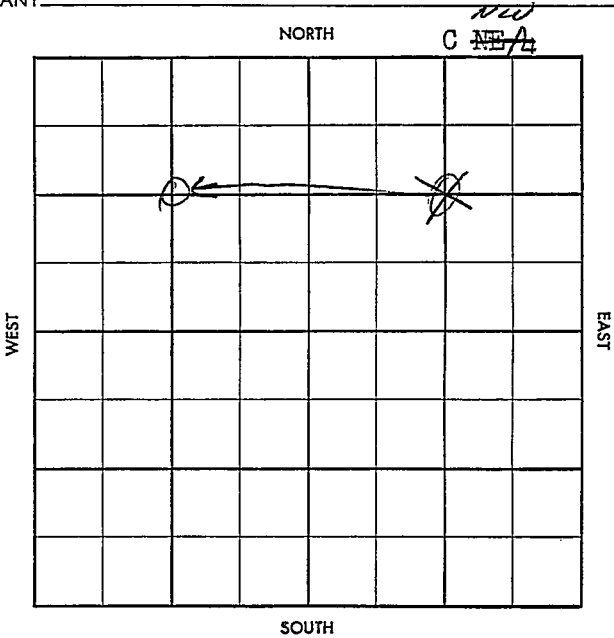

34

S-513-A

CO. ~~Morton~~ ELEV. _____
SEC. 24 TWP. 34 RGE. 43W
COMPANY Panhandle NO. 1

SEP 25 '57

FIRST REPORT

FARM Kansas

LOC. C NE/4 1320' NL
1270' WL

GEOL. _____

CONTR. H & H

POOL Greenwood

SPUD _____
R U R

CO.

LSE.

NO.

SEC.

TWP.

RGE.

20

DEC 11 1957 DEC 16 57 JAN 8 58
JAN 15 State deliverability
Ga 1.101 net RP 391
BTU 924