


Section 24 Township 34 Range 41WWell No. #1 Becker "E"Company Cities Service Oil

NORTH

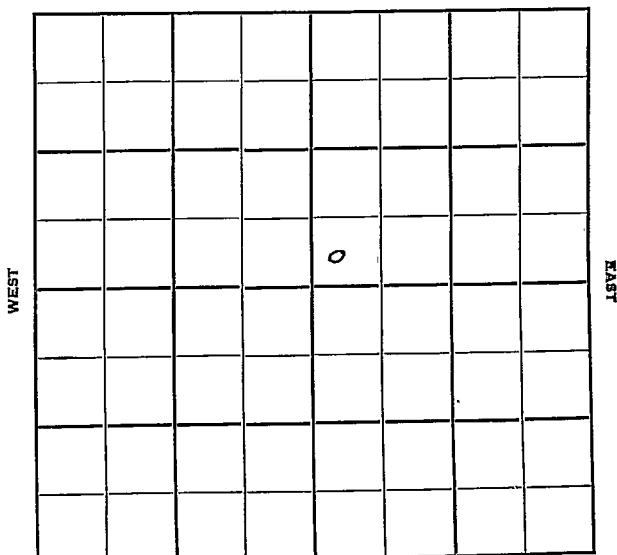

SOUTH

Sec. 24 Twp. 34 R. 41WWell No. #1 Becker "E" Farm _____Cities Service Oil Company _____

Contractor _____


Ft. from N. Line

225 Ft. from S. Line

Ft. from E. Line

225 Ft. from W. Line

SW NE

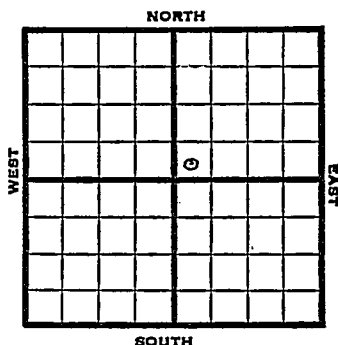

1952

Elev. 3410' REPORT

10/15

Spud 10-10-52

8" @ 360'

Dr1g. 2040'

10/22

RTD 2485' 5" @ 2484'

10/29

NR

11/5

CO 2468

30/2462-68, 60/2438-50

20/2430-34, 1500A

Krider 2377', Winfield 2438'

11/12

50/2398-2408 70/2380-75 17,000 A

11/19

Spud 10-10-52

Gas Well

TD 2485'

8" @ 360

Kri 2377, Win. 2438,

TD 2485,

5" @ 2484

CO to 2468

30/2462-68, 60/2438-50, 20/

2430-34, 50/2398-2408, 70/

2380-94, 17000A

Comp. 7,150,000 gas

COMPLETED

J. G. McGEHEE



J. G. McGEHEE