


Form 51-5M-2-29-34703
Map No. *Morton* **KANSAS** Sec. *24* Twp. *34* R. *40^W*
Well No. *1-Little* Farm
Argus Gas Company
NORTH

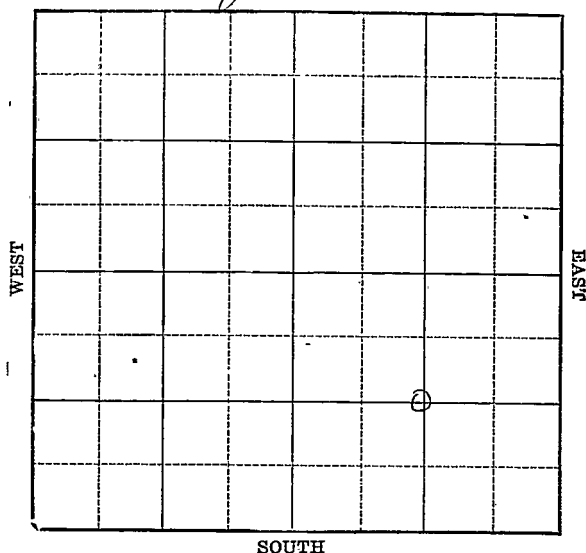

Location
Drilling Remarks

Rig Up
Drilling Remarks

RECORD

Cased _____ in. _____ ft.
Sand _____
Gas _____
Oil _____
Total Depth _____

PRODUCTION

1st 24 hrs. Nat. _____
1st 24 hrs. after shot _____
Gas _____ cu. ft. _____
Dry Hole _____
Abandoned _____


Map No. KANSAS Sec. 24 Twp. 34 R. 40^w
 Well No. 1- Little Farm
Cirque Gas Company

 Ft. from N. Line

1320 Ft. from S. Line

1320 Ft. from E. Line

1930 Ft. from W. Line

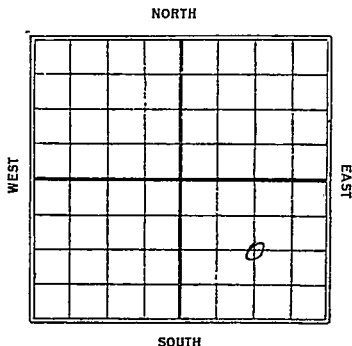

Date

REPORT

4/30

Loc.

5/7

Rsg

5/14

Rign up

5/21

hellg. 122.5'

5/28

" 2055'

6/4

" 2210'

6/11

Rust 2534'

6/18

hellg. 2763'

6/25

Edr. 57A gas

and 2534-2902

TD 2902

Comp. T¹/₂ M gas


*Morton*Map No. KANSAS Sec. 24 Twp. 34 R. 40 WWell No. 1 LittleArgus Gas CompanyJ Contractor

SECTION PLAT

.....Ft. from N. Line

1320 Ft. from S. Line1320 Ft. from E. Line

.....Ft. from W. Line

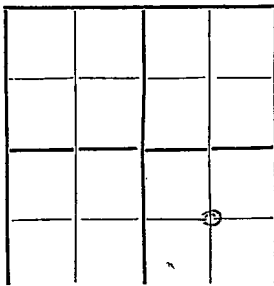

FIRST REPORTS

Location.....✓

Rig up.....

Drilling and Remarks:

RECORD

Cased.....in.,ft.

Sand.....

Gas.....

Oil.....

Total Depth.....

PRODUCTION

1st 24 hrs. Nat.....

1st 24 hrs. after shot.....

Gas.....Cu. Ft.

Dry Hole.....

Abandoned.....

Date

APR 30 1930

S. J. LEWIS

Scout

Morton
 Map No. **KANSAS** Sec. *24* Twp. *34* R. *40W*

Well No. *1 Little*

Argus Gas Company

J Contractor


SECTION PLAT

.....Ft. from N. Line

1320 Ft. from S. Line

1320 Ft. from E. Line

.....Ft. from W. Line

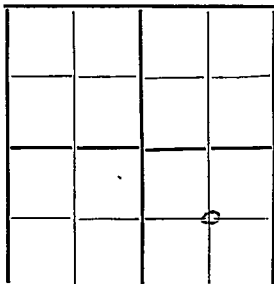

COMPLETED

Location.....

Rig up.....

Drilling and Remarks:

7 1/2 M Gas

RECORD

Cased.....in.,ft.

Sand *2034-2902*

Gas.....

Oil.....

Total Depth: *2902*

PRODUCTION

1st 24 hrs. Nat.....

1st 24 hrs. after shot.....

Gas.....Cu. Ft.

Dry Hole.....

Abandoned.....

Date

JUN 25 1930

S. J. LEWIS Scout