

Barber


KANSAS

SECTION 25 TOWNSHIP 34 RANGE 13 W

WELL NO. #1 Ed Sterling

COMPANY Sinclair O & G

NORTH

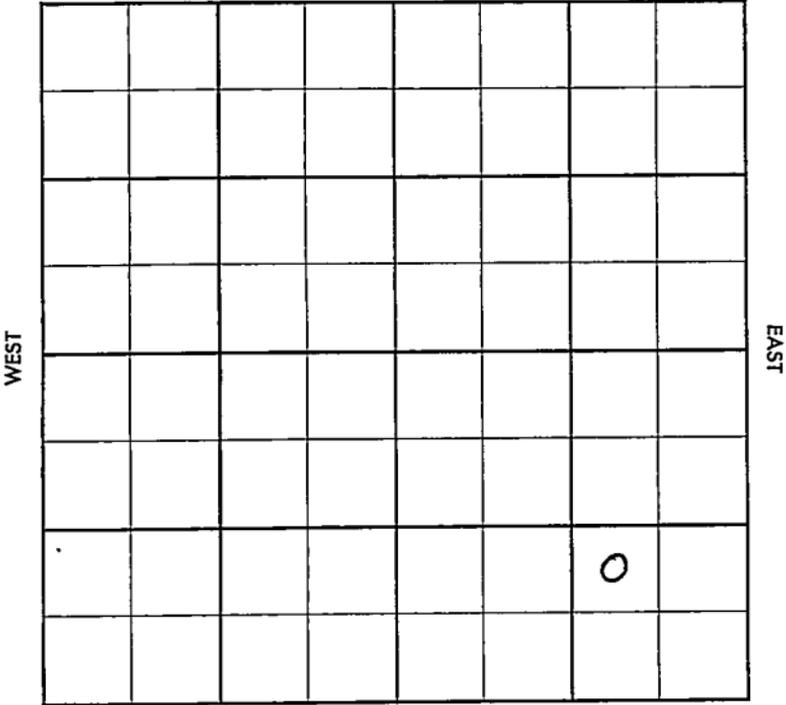

SOUTH

Barber

KANSAS

SEC.	25	TWP.	34	R.	13W
------	----	------	----	----	-----

WELL NO. #1 Ed Sterling FARM

COMPANY Sinclair O & G

CONTRACTOR Hardtner


_____ Ft. from N. Line

_____ Ft. from S. Line

_____ Ft. from E. Line

_____ Ft. from W. Line

NW SE SE

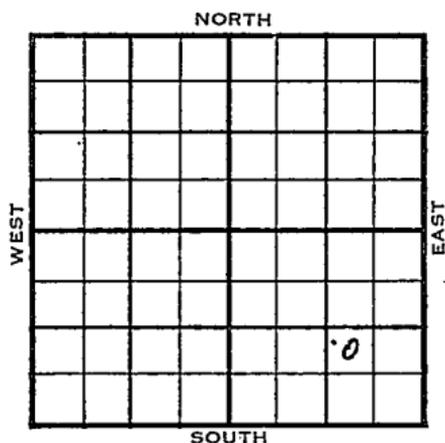

	ELEVATION	REPORT
1955	1498'	
10/26	10" @ 273 w/225 WOC	
11-30	DST 4782-4806 op 2 hrs. gas in 8 min. 150 mcfg, rec. 97' gcm, 25' gc&hvy froggy oil, 1862/30" DST 4809-59 op 2 hrs. gas 2890 mcfg, rec. 20' hocm, 1835/30" 5 1/2" @ 4916/20, 42/ 4814-21, 72/ 4825-37 frac, F/ 1630 mcfgpd Comp. 6507 mcfgpd Elg. 3639-3634 H. 3873-3858 Tr. 3888-3888 Dg. 3958' L. 4070-4066 KC 4384 Marm 4656 Burg 4777-4765 M. 4807 4804 TD 4920'	

COMPLETED

County Barber Elev. 1108
 Sec. 25 Twp. 31 Rge. 13W
 Company Sinclair O & G
 Farm Name Ed Sterling No. 1

TOPS	DEPTH	LOG	DATUM
Anh.			
Tp.			
H.			
Tr.			
Dg.			
Bl.			
L.			
K.C.			
B.K.C.			
Ce.			
C.			
M.			
M.			
K.			
Mz.			
Mq.			
V.			
S.			
S.			
A.			
R.			
PE.			
G.			
T.D.			

Loc. in Sec. NW SE SE
 Geol. _____
 Contr. _____
 Pool Hardtner
 OCT 26 '55
 FIRST REPORT
 No. _____
 Sec. _____
 T. _____
 R. _____

Date Comm. 10th @ 273/225 WOC

[Handwritten signature]

County Barber Elev. 1198
 Sec. 25 Twp. 34 Rge. 13W
 Company Sinclair O & G
 Farm Name Ed Sterling No. 1

TOPS	DEPTH	LOG	DATUM
Anh. <u>E19</u>	<u>3639</u>	<u>3634</u>	<u>21310</u>
Tr.			
H.	<u>3873</u>	<u>3858</u>	<u>23100</u>
Tr.	<u>3888</u>	<u>3888</u>	<u>2390</u>
Dg.	<u>3958</u>		<u>2460</u>
Bl.			
L.	<u>4070</u>	<u>4066</u>	<u>25108</u>
K.C.	<u>4384</u>		<u>28810</u>
B.K.C. <u>Manning</u>		<u>410510</u>	<u>3158</u>
Ce. <u>Manning</u>	<u>4777</u>	<u>4765</u>	<u>32107</u>
C.			
M.	<u>4817</u>	<u>4804</u>	<u>33010</u>
M.			
K.			
Mz.			
Mo.			
V.			
S.			
S.			
A.			
R.			
PE.			
G.			
T.D.	<u>4920</u>		


Loc. in Sec. NW SE SE

Geol.

Contr.

Pool

Hardtner

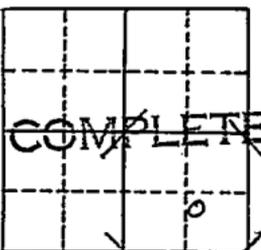

NOV 30 1955

Date Comm.

10" @ 273/225 DST 4782-4806 open 2 hr

gas in 8 min. 150 mcfg Rec. 97' gcm

25' gc & hvy froggy oil 1862/30"

DST 4809-59 open 2 hr. gas 2890 mcfg

rec. 20' hocm 1835/30" 5 1/2" @ 4916/200

42/ 4814-21 72/ 4825-37 frac

F/ 1,630 mcfgpd Comp. 6,507 mcfgpd