


Section 25 Township 34 Range 26W
Well No. #1 McKinney "C"
Company Skelly Oil

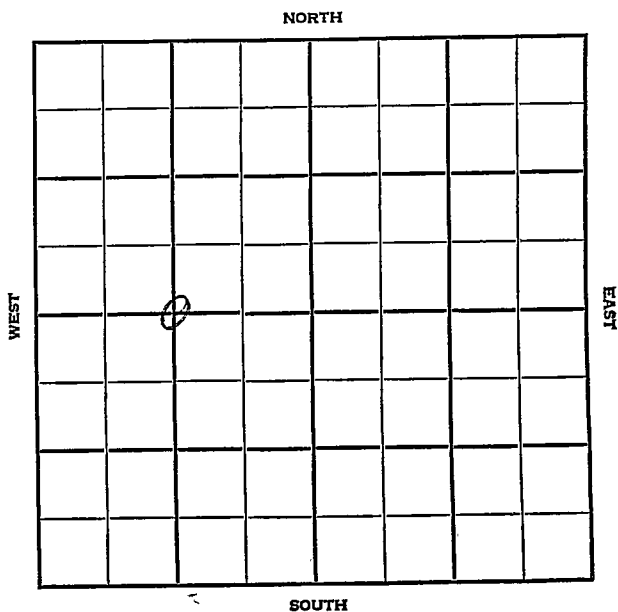

County Meade Elev. _____
 Sec. 25 Twp. 34 Rge. 26W
 Company Skelly Oil
 Farm Name McKinney No. 1

TOPS

DEPTH

LOG

DATUM

Loc. in Sec.

C W/2 of sec.

Anh.

Tp.

H.

Tr.

Dg.

Bl.

L.

K.C.

B.K.C.

Ce.

C.

M.

M.

K.

Mz.

Me.

V.

S.

S.

A.

R.

PE.

G.

T.D.

Geol.

Contr.

Wentworth

Pool

McKinney

NOV 28 '55

FIRST REPORT

Date Comm.

Location

35

County Meade Elev. 2137
 Sec. 25 Twp. 34 Rge. 26W
 Company Skelly Oil
 Farm Name McKinney ("C") No. 1

TOPS	DEPTH	LOG	DATUM	Loc. in Sec.
Anh.				C W/2 of sec.
Tr.				40' S of
H.				cen of 102
Tr.				
Dg.				
Bl.				
L.	4582	4566		Geol.
K.C.				Contr.
B.K.C.	Marm	5281	5276	Wentworth
Ce.		5470	5487	
C.	Mus sh	5770	5770	
M.	" sd	5806	5815-22	
M.	chest		5880	Pool
K.				McKinney
Mz.				
Ma.				
V.				
S.				
S.				
A.				
R.				
Pe.				
G.				
Ed.	5945			

COMPLETE

JAN 30 57

Date Comm. _____

Location Det 5 50 11-30-56 85/8

931/500 WOC DEC 12 '56 17 2989

DEC 19 56 104388 DEC 26 56

DST 4736-48. 1 hr: sec 1290.'

with BHP 1770 ID 5297 JAN 2 '57

~~DST~~ crd 5800-41 DST ~~5750~~

[illegible]

2850-150" D 27-1-22 JAN 8 '51

OST 5766-5841 1hr. 6 1/2" ga.

993 MCF/15" ga 2,626 MCF end
 of test rec 90' Md BHP 2830/20
 DST 5838-99 on 1 hr rec 30'
 Md BHP 300/15" 5 1/2 @ 5945/300

JAN 16 '57 WOCT JAN 23 '57 CO 5839

24/5805-09 / 12 42/5815-22

4 hr. B.D. ga. 2,640 MCF.

Frac ga 6 MN/CFL @ 2" TB9

CP 990# JAN 20 '57 SICP 1620# :

ga 5,690 MCF @ 2" TB9

SICP 1660 calc. Ab. of Flow

12,730 MCF FP 1075#