


Section 25 Township 34 Range 30W

Well No. #5 A. W. Adams "D"

Company Columbian Fuel Corp.

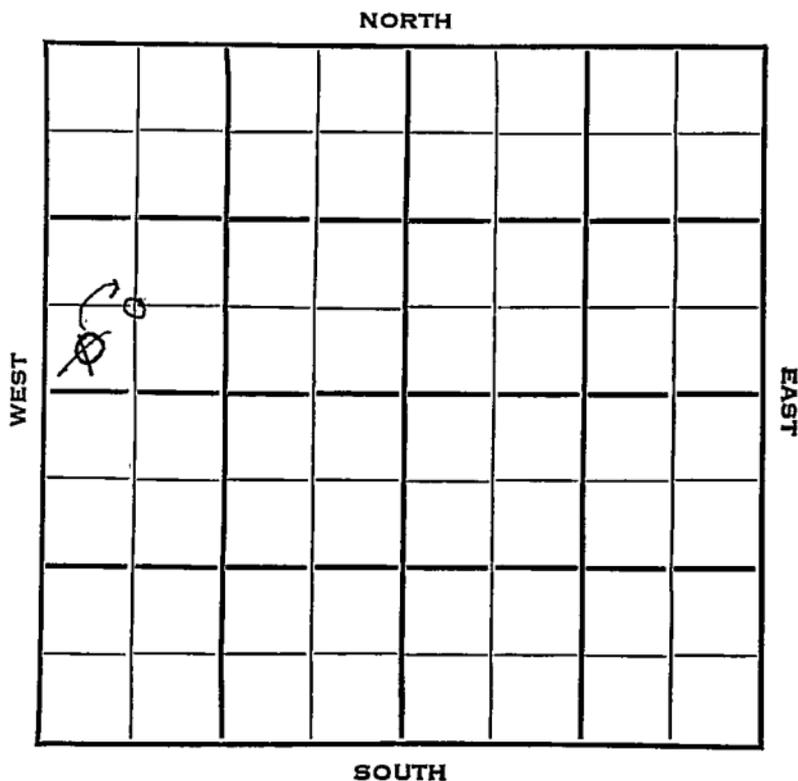

Sec. 25 Twp. 34 R. 30W

Well No. #5 A. W. Adams "D" Farm

Columbian Fuel Corp. Company


Adams Ranch Pool Contractor

 Ft. from N. Line

660
~~330~~ Ft. from S. Line

 Ft. from E. Line

660
~~330~~ Ft. from W. Line

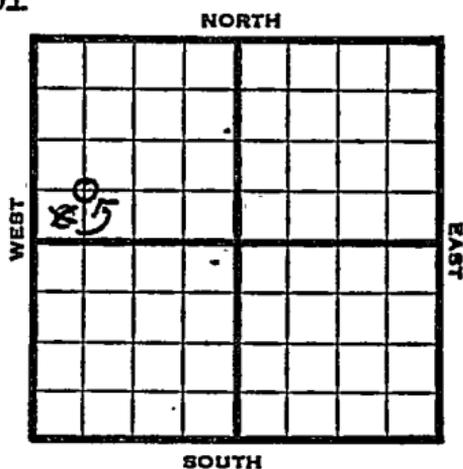

C SW NW

1953 Elev. 2633' REPORT

8/19 Location

8/26 "

9/2 13" @ 649'
TD 2710'
Schl
9" @ 2708'

9/9 Hol 2598' Her 2658'
Drlg. 4606'

9/16 DST 5350-85' 95 mins, oil in 67",
SW in 90", 570' oil, 390' SW, 1450#
TD 5385'
Schl.

9/23 Testing.

12/2 Spud 8-24-53 Oil well TD 5465
13" @ 649 Hol. 2598 Her. 2658
DST 5350-85 open 95 min, oil in 67 min
SW in 90 min, rec 570' oil, 390' SW
1450# TD 5465
DST 5352-62 open 3 1/4 hr, mud in 70 min,
oil in 1 hr, ~~200~~ 20 min. 900' free of
oil, 90' O & GCM, 5" @ 5464 GO to
5431' 12/5366-68 F/7 BFPH 10% oil
GO to 5432' 12/5363-65 2 BSWPH
GO to 5353 12/5325-27 B/1 GW
30/5351-55 B/10 GW 2 GOPH
B/9 BSW 2 GOPH 16/5351-55

OVER

1953
12/2

(Information continued)

B/7 GSW 2 GOPH 500 A F/SW
S/SW & 15 GOPH B/8 GFPH B/4 GSW
4 GOPH 300 A Sq/5351-55
B/4 GOPH B/15 GOPH 18/5351-57
19 GSW 3 GOPH B/12 GSW 3 GOPH
Hydro. S/1 BOPH S/2 GFPH 25% SW
S/67 BF 43 BO
Schl tops: Anhy 1339' Well. 2081'
Hol. 2598' Her. 2658' Kir. 2726'
Win. 2787' Ft. Riley 2858'
Florence flint 2986' Lans. 4620'
Marm. 5278'
Comp. 57 BOPD

COMPLETED

County Meade State Kansas

Sec. 25 (Blk. Twp.) 34 (Sur. Rge.) 30W Map No.

Operator Columbian Fuel Corp.

Well No. 5 Farm A. W. Adams "D"

Elev. _____ Location SW NW

0							

330 Ft. From S Line NW

330 Ft. From W Line Quarter

Ist. Report AUG 19 1953

Completion _____

Remarks _____

Spudding Date _____

Drig. Data Adams Ranch Pool

Location _____

AUG 21 1953

Scout Cards
Land Small Map
Land Wall Map
Tracings
France Map
Pierce Map
Misc.

Map No. _____ Sec. 25 Twp. 34 R. 30W

Well No. 5 Adams "D"

Columbian Fuel Corp. Company

CORRECTION Contractor

C SW NW

SECTION PLAT

_____ Ft. from N. Line

660 Ft. from S. Line

_____ Ft. from E. Line

660 Ft. from W. Line

50			

Meade County

Location _____

Rig up _____

Drilling and Remarks:

Reported
SW SW NW

RECORD

Cased _____ in., _____ ft.

Sand _____

Gas _____

Oil _____

Total Depth _____

PRODUCTION

1st 24 hrs. Nat. _____

1st 24 hrs. after shot _____

Gas _____ Cu. Ft.

Dry Hole _____

Abandoned _____

Date

SEP 2 1953

19

J. G. McGEHEE Scout

SEP 4 1953

Scout Cards	<i>AS</i>
Land Small Map	
Land Wall Map	
Tracings	
France Map	<i>AS</i>
Pierce Map	
Misc.	

Orig. Data

B / 15 goph	18 / 5351-57	19 gsw	3 goph
B / 12 gsw	3 goph	Hydro	S / 1boph
S / 2 g1ph	25% sw	S / 67 bf	43 bo

SCHLUMBERGER TOPS

Anhy 1339 Well. 2081 H.01. 2598

Her. 2658 Klr. 2726 Win. 2787

Ft. Riley 2858 Florence Flint 2986

Lans. 4620 Marm. 5278 Comp. 57 bopp

Land Small Map	
Land Wall Map	
Tracings	5
France Map	
Misc.	

DEC 8