


Section 25 Township 34 Range 30WWell No. #2 Adams (F)Company Columbia Fuel

NORTH

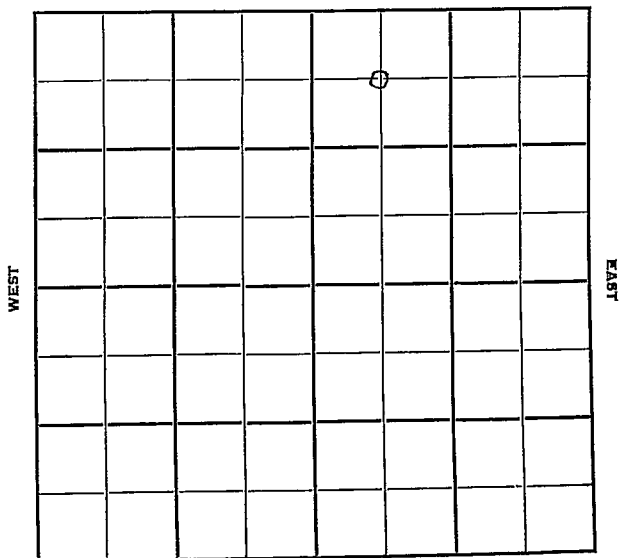

SOUTH

Sec. 25 Twp. 34 R. 30WWell No. #2 Adams (F) FarmColumbia Fuel Company

Contractor

Adams Ranch


660 Ft. from N. Line

Ft. from S. Line

Ft. from E. Line

660 Ft. from W. Line

C NW NE

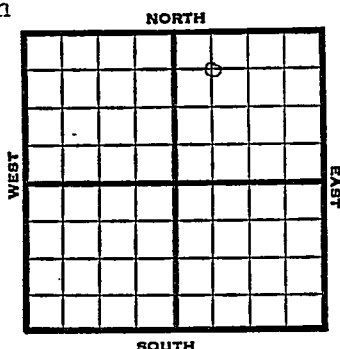

1951 Elev. 2595' REPORT

10/10 Location

1952

1/23

Spud 10-15-51

Gas Well TD 6055

10" @ 653' 9" @ 2667'

DST 4500-19 open $\frac{1}{2}$ hr. rec. 60'

mud & wtr. 120' SW

DST 5351-81 open 1 hr. rec. 60' SW &
mud 320' SWDST 5840-75 open 1 hr. gas in 18 min.
rec. 35' SGCM 108,000 gas

DST 5886-5925 open 1 hr. rec. 63' GCM

TD 6055 DST 5962-6055 open 1 hr.

rec. 30' SGMM 5" @ 5965 CO to 5927

9/ 5902-05 939,000 gas 15/ 5897-5902

104,000 gas 42/ 5897-5905 Hydro.

est. 2 MCFG Lans. 4494 Marm. 5320

Cherokee 5480 Morrow 5850

Comp. 2,400,000 gas

COMPLETED

County Meade State KansasSec. 25 (Blk.) 34 (Sur.) 30W Map No.Operator Columbia FuelWell No. 2 Farm Adams (F)Elev. Location C NW NE

660 Ft. From N Line NE660 Ft. From W Line Quarter1st. Report OCT 10 1951

Completion


Remarks

Spudding Date

Drlg. Data Adams RanchLocation

J. E. TYRA

County Meade State Kansas
 Sec. 25 (Blk. 34) (Sur. 30W) Map No.
 Operator Columbia Fuel
 Well No. 2 Farm Adams "F"
 Elev. 2595 Location C NW NE

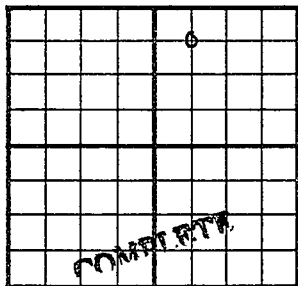

660 Ft. From N' Line NE

660 Ft. From W Line Quarter

1st. Report

Completion JAN 23 1952

Remarks Adams Ranch Pool

Spudding Date 10-15-51

Drlg. Data Gas well TD 6055

10" @ 653 9" @ 2667 DST 4500-19

open $\frac{1}{2}$ hr. Rec. 60' mud & water 120' sw

DST 5351-81 open 1 hr. Rec. 60' sw & mud

320' sw DST 5840-75 open 1 hr. gas

in 18 min. Rec. 35' sgcm 108,000 gas

DST 5886-5925 open 1 hr. Rec. 63' gcm

TD 6055 DST 5962-6055 open 1 hr.

Rec. 30' sgcm 5" @ 5965 CO to 5927

9/ 5902-05 939,000 gas 15/ 5897-5902

104,000 gas 42/ 5897-5905 Hydro.

est 2 mcf/g Lans. 4494 Marm. 5320

Cherokee 5480 Morrow 5850

Comp. 2,400,000 gas

J. G. McGEHEE