


Section 25 Township 34 Range 32 W

Well No. #1 L. H. Fincher

Company Shamrock Oil

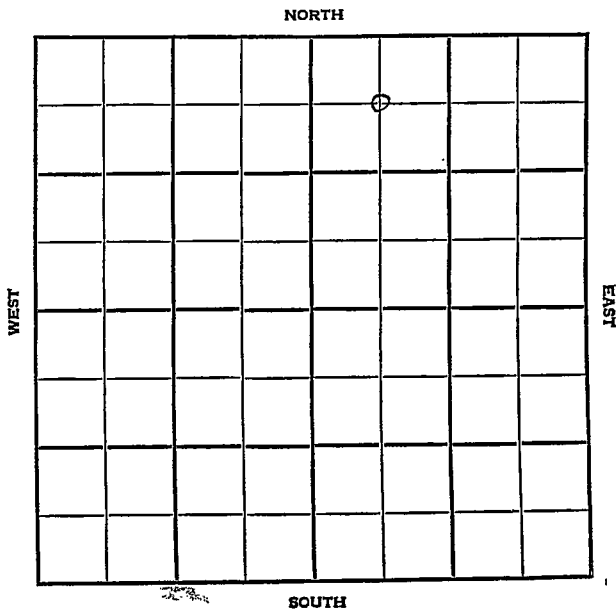

## Seward

KANSAS

SEC.	25	TWP.	34	R.	32W
------	----	------	----	----	-----

WELL NO. #1 L. H. Fincher FARM

COMPANY Shamrock Oil

CONTRACTOR Columbia Fuel & United - FO


Wildcat

\_\_\_\_\_ Ft. from N. Line

\_\_\_\_\_ Ft. from S. Line

\_\_\_\_\_ Ft. from E. Line

\_\_\_\_\_ Ft. from W. Line

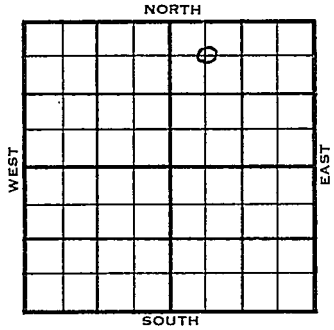

C NW NE

	ELEVATION	REPORT
1955	2753	

8/17 Location

9/28

Comm 8-17-55  
 13 3/8" @ 719 w/600  
 9 5/8" @ 2699 w/800  
 Dela 2678  
 Kri 2730 2730  
 W Fd 2800 2801  
 U Ft Rly 2865 2854  
 L " " 2925 2930  
 Shawnee 4429  
 Lsg 4557 4567  
 Marm 5292 5285  
 Morr 5860  
 Chest 6088  
 TD 6164  
 Crd 6059-89 Rec 25' 8"  
 Crd 6089-95 no rec  
 Crd 6096-6104 no rec  
 DST 6060-6104 open 75" rec 30' mud  
 press D & A

**ABANDONED**

County Seward Elev. \_\_\_\_\_  
 Sec. 25 Twp. 34 Rgs. 32W  
 Company Shamrock Oil  
 FarmName L. H. Fincher No. 1

TOPS	DEPTH	LOG	DATUM
Anh.			
Tp.			
H.			
Tr.			
Dg.			
Bl.			
L.			
K.C.			
B.K.C.			
Ce.			
C.			
M.			
M.			
K.			
Mz.			
Me.			
V.			
S.			
S.			
A.			
R.			
PE.			
G.			
T.D.			

Loc. in Sec. C NW NE  
600' fml x  
1980' fel  
 Geol. \_\_\_\_\_  
 Contr. Columbia  
Fuel & United  
(FO)  
 Pool W.C.

0  
 AUG 17 '55  
**FIRST REPORT**

Date Comm. \_\_\_\_\_ Loc. \_\_\_\_\_  
 \_\_\_\_\_  
 \_\_\_\_\_  
~~32~~

Co. No. Sec. T. R.

County Seward Elev. 2753  
 Sec. 25 Twp. 34 Rgs. 32W  
 Company Shamrock Oil  
 Farm Name J. H. Fincher No. 1

TOPS	DEPTH	LOG	DATUM	Loc. in Sec.
Anh.				C NW NE
Tr.				600' NL
Dg.				1980' EL
Dr. <u>Dala</u>	<u>2678</u>			
L.				Geol.
K.C. <u>Kri</u>	<u>2730</u>	<u>2730</u>		Contr. <u>Columbia</u>
B.K. <u>W. Fd</u>	<u>2800</u>	<u>2801</u>	<u>48</u>	<u>Fuel &amp; United</u>
Co. <u>U Ft Rly</u>	<u>2865</u>	<u>2864</u>	<u>111</u>	FO
G. <u>L Ft Rly</u>	<u>2925</u>	<u>2930</u>	<u>177</u>	Pool
M. <u>Shawnee</u>	<u>4429</u>		<u>1676</u>	W.C.
N. <u>Lsg</u>	<u>4557</u>	<u>4567</u>	<u>1814</u>	
K. <u>Marm</u>	<u>5292</u>	<u>5285</u>	<u>2532</u>	
Mz. <u>Morr</u>		<u>5860</u>	<u>3107</u>	
Mo. <u>Chest</u>		<u>6088</u>	<u>3335</u>	
V.				
S.				
S.				
A.				
R.				
PE.				
G.				
TD.	<u>6164</u>			SEP 28 1955

Date Comm. 8/17/55  
 13 3/8" 719 w/600 9 5/8" 2699 w/800  
 Crd. 6059-89 Rec. 25' 8"  
 Crd. 6089-95 no rec.  
 Crd. 6096-6104 no rec.  
 DST 6060-6104 open 75" Rec. 30' mud press 0  
 D & A