


Section 25 Township 34 Range 34W

Well No. #1 Tucker

Company Hugoton Prod.

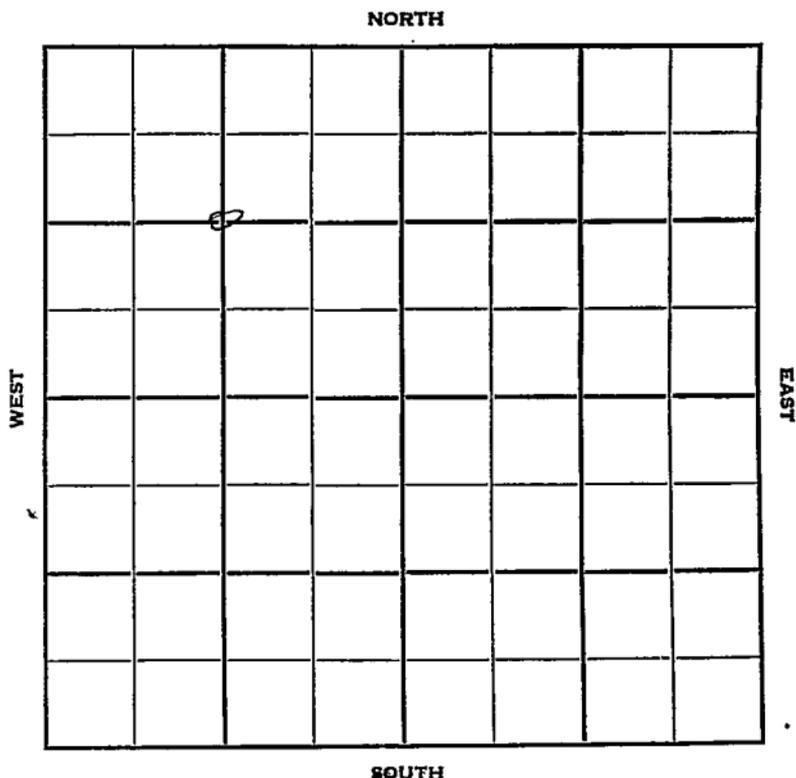

Sec. 25 Twp. 34 R. 34W

Well No. #1 Tucker Farm

Hugoton Prod. Company

Contractor

Hugoton Pool


1320' Ft. from N. Line

Ft. from S. Line

Ft. from E. Line

1320' Ft. from W. Line

C NW/4

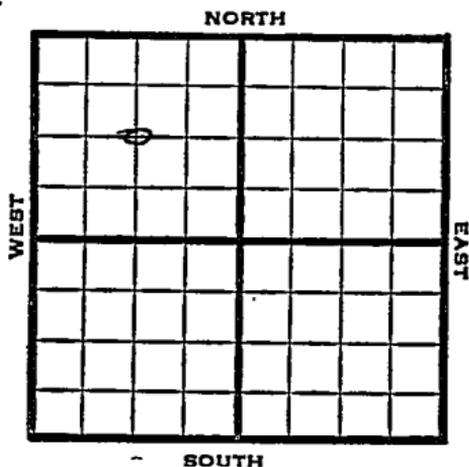

1951

Elev. 2887' REPORT

2/28

Location

6/20

Spud 2-26-51 Gas well TD 2694'  
 10" @ 651 7" @ 2689 TD 2694'  
 90/2675-90 30/2666-71 90/2648-63  
 90/2627-42 30/2622-25  
 Hol. 2552' Her. 2616' Krider 2648'  
 18,000 A  
 Comp. 898,000 gas

**COMPLETED**



County Seward State Kansas

Sec. 25 (Blk. Twp.) 34 (Sur. Rge.) 34W Map No.

Operator Hugoton Prod.

Well No. 1 Farm Tucker

Elev. 2887 Location C NW/4


1320 Ft. From N Line NW

1320 Ft. From W Line Quarter

1st. Report \_\_\_\_\_

Completion JUN 20 1951

Remarks Hugoton Pool

Spudding Date 2-26-51

Drilg. Data Gas well TD 2694

10" @ 651 7" @ 2689 TD 2694 90/ 2675-

90 30/ 2666-71 90/ 2648-63 90/ 2627-42

30/ 2622-25 Hol. 2552 Her. 2616

Krider 2648 18000 A Comp. 898,000 gas