


Section 23 5 Township 34 Range 42W
Well No. #1 Brown "F"
Company Cities Service

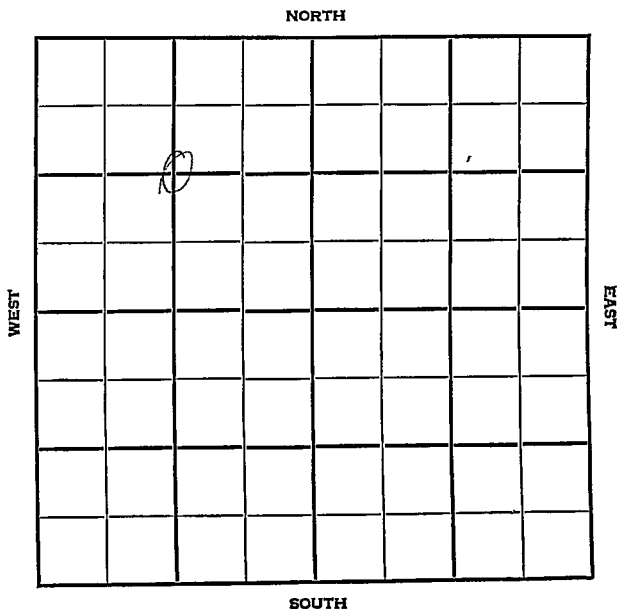

County Morton Elev. _____
 Sec. 23 Twp. 34 Rge. 12W
 Company Cities Service
 Farm Name Brown "F" No. 1

TOPS	DEPTH	LOG	DATUM	Loc. in Sec.
Anh.				C NW/4
TP.				
H.				
Tr.				
Dg.				
BL.				
L.				Geol.
K.C.				Contr.
B.K.C.				Holm Drig.
Ce.				Pool
C.				Greenwood
M.				
M.				
K.				
Mz.				
Ma.				
V.				
S.				
S.				
A.				
R.				
Pe.				
G.				
T.D.				

JAN 9 '57	
FIRST REPORT	

Date Comm. 1-6-57

811 @ 601/100

34

