

TYPE

AFFIDAVIT OF COMPLETION FORM

ACO-1 WELL HISTORY

SIDE ONE

18-34-26W-<sup>Comp.</sup>

Two (2) copies of this form shall be filed with the Kansas Corporation Commission, 200 Colorado Derby Building, Wichita, Kansas 67202, within thirty (30) days after the completion of a well, regardless of how the well was completed.

Attach separate letter of request if the information is to be held confidential. If confidential, only file one copy. Information on Side One will be of public record and Side Two will then be held confidential.

Applications must be made on dual completion, commingling, salt water disposal, injection and temporarily abandoned wells.

Attach one copy only wireline logs (i.e. electrical log, sonic log, gamma ray neutron log, etc.). (Rules 82-2-105 & 82-2-125) KCC# (316) 263-3238.

LICENSE # 5703 EXPIRATION DATE 6-30-84

OPERATOR J. M. Huber Corporation API NO. N/A

ADDRESS 7120 I-40 West COUNTY Meade

Amarillo, Texas 79106 FIELD McKinney

\*\* CONTACT PERSON William D. Siddens PROD. FORMATION Morrow  
PHONE 806/353-9837

PURCHASER Northern Natl. Gas & Kansas Power & Light LEASE Painter B

ADDRESS 2130 N. Highway 83 818 Kansas Avenue WELL NO. 1

Liberal, Kansas 67901 Topeka, Ks 66601 WELL LOCATION C SE/4

DRILLING Capitt Drilling Inc. 1320 Ft. from east Line and

CONTRACTOR Suite 814 Union Center 1320 Ft. from south Line of

ADDRESS Wichita, Kansas (1959 address) the SE (Qtr.) SEC 18 TWP 34 SR GE 26 (K) (W)

PLUGGING CONTRACTOR ADDRESS

WELL PLAT (Office Use Only)

TOTAL DEPTH 6170' PBTD 6131'

SPUD DATE 1-27-59 DATE COMPLETED 2-22-59

ELEV: GR 2390' DF 2401' KB 2402'

DRILLED WITH (CABLE) (ROTARY) (DR) TOOLS.

DOCKET NO. OF DISPOSAL OR REPRESSURING WELL BEING USED TO DISPOSE OF WATER FROM THIS LEASE

Amount of surface pipe set and cemented 1435' DV Tool Used? No

THIS AFFIDAVIT APPLIES TO: (Circle ONE) - Oil, Gas, Shut-in Gas, Dry, Disposal, Injection, Temporarily Abandoned, OWWO. Other


ALL REQUIREMENTS OF THE STATUTES, RULES AND REGULATIONS PROMULGATED TO REGULATE THE OIL AND GAS INDUSTRY HAVE BEEN FULLY COMPLIED WITH.

A F F I D A V I T

Richard Battley, being of lawful age, hereby certifies that:

I am the Affiant, and I am familiar with the contents of the foregoing Affidavit. The statements and allegations contained therein are true and correct.

Richard Battley

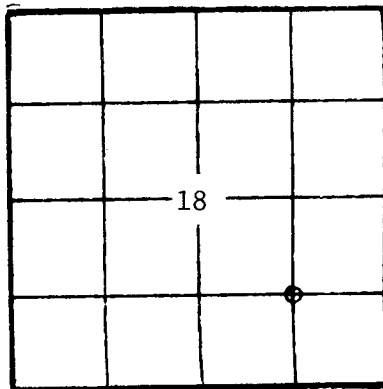

(Office Use Only) KCC KGS SWD/REP PLG.

SIDE TWO

18-34-26 WP  
ACQ 1 WELL HISTORY (E) (W)

OPERATOR J. M. Huber Corporation LEASE Painter B SEC. 18 TWP. 34 SRGE. 26

FILL IN WELL INFORMATION AS REQUIRED: WELL NO. 1

Show all important zones of porosity and contents thereof; cored intervals, and all drill-stem tests, including depth interval test-c, cushion used, time tool open, flowing and shut-in pressures, and recoveries.

SHOW GEOLOGICAL MARKERS, LOGS RUN, OR OTHER DESCRIPTIVE INFORMATION.

FORMATION DESCRIPTION, CONTENTS, ETC.	TOP	BOTTOM	NAME	DEPTH
<u>X</u> Check if no Drill Stem Tests Run.			Microlaterlog	4675'-6162'
			Laterlog w/GR	1437'-6160'
Cored 6055'-6105'				

**ACID, FRACTURE, SHOT, CEMENT SQUEEZE RECORD**

Amount and kind of material used	Depth interval treated
10,000 gal 7½% MCA	5976-6104' OA
10,000 gal X 10,000 # sand	5976-6104' OA
17,000 gal 3% acid X 15000# sand	5976-6104' OA
Date of first production 10-59	Producing method (flowing, pumping, gas lift, etc.) Flowing
Estimated Production -I.P.	Gravity .663
Oil	Gas CAOF 4600
Water %	Gas-oil ratio
Disposition of gas (vented, used on lease or sold) Sold	Perforations 5976-6104' OA

**Report of all strings set — surface, intermediate, production, etc. CASING RECORD (New) or (Used)**

Purpose of string	Size hole drilled	Size casing set (in O.D.)	Weight lbs/ft.	Setting depth	Type cement	Sacks	Type and percent additives
Surface	12¼"	8 5/8"		1435'	50/50 Poz	750	2% CaCl₂
Production	7 7/8"	5 1/2"	15.5	6162	Common	200	

**LINER RECORD**

**PERFORATION RECORD**

Top, ft.	Bottom, ft.	Sacks cement	Shots per ft.	Size & type	Depth interval
					5976-5994'
					6000-04'
					6021-30, 6084-6104'
					6058-74'
TUBING RECORD					
Size	Setting depth	Packer set at			
2 3/8"	6011'	6011'	4		