C SIDE ONE

STATE CORPORATION COMMISSION OF KANSAS
OIL & GAS CONSERVATION DIVISION

WELL COMPLETION OR RECOMPLETION FORM
ACO-1 WELL HISTORY

API NO. 15 - 119-20,730

County Meade

NE NE NE (location) Sec 31 Twp 34 Rge 26 [ ] East [X] West

4950 Ft North from Southeast Corner of Section
330 Ft West from Southeast Corner of Section
(Note: locate well in section plat below)

Lease Name Fincham Well# 4-31

Field Name McKinney

Producing Formation Morrow

Elevation: Ground 2285' KB 2295'

Section Plat

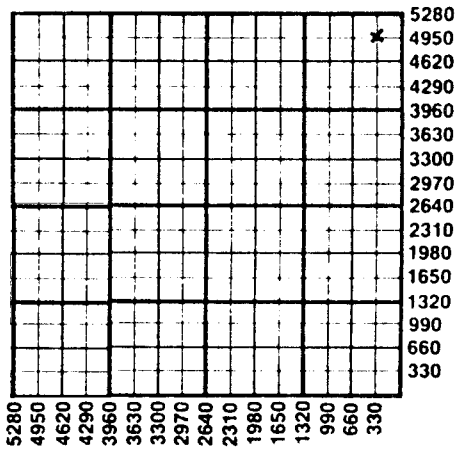

DESCRIPTION OF WELL AND LEASE

Operator: license # 8060
name Zinke & Trumbo, Ltd.
address 111 W. 5th, Suite 220
Grantson Bldg.
City/State/Zip Tulsa, Okla. 74103

Operator Contact Person Ron F. Crowell
Phone 918-592-5096

Contractor: license # 6333
name DaMac Drilling, Inc.

Wellsite Geologist None
Phone

Designate Type of Completion
[X] New Well [ ] Re-Entry [ ] Workover

[ ] Oil [ ] SWD [ ] Temp Abd
[X] Gas [ ] Inj [ ] Delayed Comp.
[ ] [ ] Other (Core, Water Supply etc.)

If OWWO: old well info as follows:
Operator
Well Name
Comp. Date Old Total Depth

WELL HISTORY

Drilling Method: [X] Mud Rotary [ ] Air Rotary [ ] Cable

9/24/85 — Spud Date
10/8/85 — Date Reached TD
10/17/85 — Completion Date

6300' — Total Depth
6237' — PBTD

Amount of Surface Pipe Set and Cemented at 1511 feet

Multiple Stage Cementing Collar Used? [ ] Yes [X] No

If Yes, Show Depth Set feet

If alternate 2 completion, cement circulated
from feet depth to w/ SX cmt

WATER SUPPLY INFORMATION

Source of Water:

Division of Water Resources Permit #

[ ] Groundwater Ft North From Southeast Corner and
(Well) Ft. West From Southeast Corner o
Sec Twp Rge [ ] East [ ] West

[ ] Surface Water Ft North From Sourtheast Corner and
(Stream, Pond etc.) Ft West From Southeast Corne
Sec Twp Rge [ ] East [ ] West

[ ] Other (explain)
(purchased from city, R.W.D.#)

Disposition of Produced Water: [ ] Disposal [ ] Repressuring

Docket #

INSTRUCTIONS: This form shall be completed in duplicate and filed with the Kansas Corporation Commission, 200 Colorado Derby Building, Wichita, Kansas 67202, within 90 days after completion or recompletion of any well. Rules 82-3-130 and 82-3-107 apply.

Information on side two of this form will be held confidential for a period of 12 months if requested in writing and submitted with the form. See rule 82-3-107 for confidentiality in excess of 12 months.

One copy of all wireline logs and drillers time log shall be attached with this form. Submit CP-4 form with all plugged wells. Submit CP-111 form with all temporarily abandoned wells.