

STATE CORPORATION COMMISSION OF KANSAS
OIL & GAS CONSERVATION DIVISION
WELL COMPLETION OR RECOMPLETION FORM
ACO-1 WELL HISTORY
DESCRIPTION OF WELL AND LEASE

Operator: License # 08060
Name Zinke & Trumbo, Ltd.
Address 111 W. 5th
Suite 220
City/State/Zip Tulsa, Oklahoma 74103

Purchaser Enron Gas Marketing
Tulsa, Oklahoma 74136

Operator Contact Person Keith Hill
Phone (316) 624-0156

Contractor: License # 5380
Name Eagle Drilling, Inc.

Wellsite Geologist David B. Trumbo
Phone (918) 592-5096

Designate Type of Completion

☒ New Well ☐ Re-Entry ☐ Workover

☐ Oil ☐ SWD ☐ Temp Abd
☐ Gas ☐ Inj ☐ Delayed Comp.
☐ Dry ☐ Other (Core, Water Supply etc.)

If ONWO: old well info as follows:

Operator
Well Name
Comp. Date Old Total Depth

WELL HISTORY

Drilling Method:

☒ Mud Rotary ☐ Air Rotary ☐ Cable

02/14/87 02/23/87 03/19/87
Spud Date Date Reached TD Completion Date

6210' 6147'
Total Depth PBDT

Amount of Surface Pipe Set and Cemented at 1460 feet
Multiple Stage Cementing Collar Used? Yes ☒ No
If yes, show depth set feet
If alternate 2 completion, cement circulated
from feet depth to w/ SX cmt
Cement Company Name Dowell/Schlumberger
Invoice # Liberal, Kansas

API NO. 15-119-20,753
County Meade 32-34-26W
NE SW Sec 32 Twp 34S Rge 26 East
..... X West

1980 Ft North from Southeast Corner of Section
3630 Ft West from Southeast Corner of Section
(Note: Locate well in section plat below)


Lease Name O'Brien-Barby Well # 2-32

Field Name Fincham/O'Brien-Barby

Producing Formation Morrow

Elevation: Ground 2224' 2237' KB

Section Plat

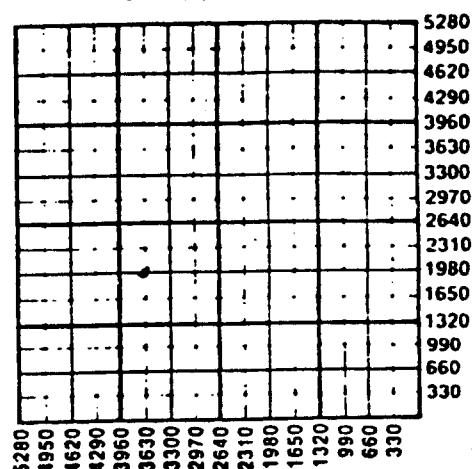

WATER SUPPLY INFORMATION

Disposition of Produced Water: Disposal
Docket # Repressuring

Questions on this portion of the ACO-1 call:

Water Resources Board (913) 296-3717

Source of Water:

Division of Water Resources Permit #

☒ Groundwater 660 Ft North from Southeast Corner
(Well) 660 Ft West from Southeast Corner of
Sec 31 Twp 34S Rge 26 East XX West

Surface Water Ft North from Southeast Corner
(Stream, pond etc) Ft West from Southeast Corner
Sec Twp Rge East West

Other (explain)
(purchased from city, R.W.D. #)

INSTRUCTIONS: This form shall be completed in triplicate and filed with the Kansas Corporation Commission, 200 Colorado Derby Building, Wichita, Kansas 67202, within 120 days of the spud date of any well. Rule 82-3-130, 82-3-107 and 82-3-106 apply.
Information on side two of this form will be held confidential for a period of 12 months if requested in writing and submitted with the form. See rule 82-3-107 for confidentiality in excess of 12 months.
One copy of all wireline logs and drillers time log shall be attached with this form. Submit CP-4 form with all plugged wells. Submit CP-111 form with all temporarily abandoned wells.