


KANSAS CORPORATION COMMISSION

WELL RECORD

(Mail to Kansas Geological Survey, 4150 Monroe Street, Wichita, Kansas 67209)

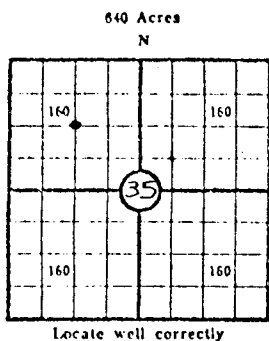

API# 15-119-20, 120

Lease Name: WALKER Well No. 1
 Well Located: App. C NW/4
SEC 35 TWP 34S RGE 26W
 Operator: THE HEADINGTON COMPANY
 Address: 801 First Nat'l. Bldg., Okla. City, Okla.
 Elevation: Ground 2198 D.F. 2201 K.B. 2203
 Type Well: (Oil, gas, dry hole) Gas Well

Drilling Commenced: November 3 1972 Drilling Completed: November 19 1972
 Well Completed: December 7 1972 Total Depth 5975'
 Initial Production: Open Flow 661 MCF/DAY (not connected as yet)

Casing Record

Size: 8-5/8 Set at 1192' Size: Set at
 Size: 4-1/2 Set at 5974' Size: Set at

Liner Record

Size: None Set from To

Cementing

Casing Size	Sacks	Type Cement and Additives
<u>8-5/8</u>	<u>450</u>	<u>50-50 pos - 6% Gel, 2% CaCL</u>
<u> </u>	<u>150</u>	<u>Regular - 2% CaCL</u>
<u>4-1/2</u>	<u>100</u>	<u>10% Salt 10# Gilsonite, 2% gel.</u>

Perforations

Formation	Perforated Interval and Number Shots
<u>Morrow</u>	<u>12 holes - 5905-5911'</u>
<u> </u>	<u>4 holes - 5919-5921'</u>
<u> </u>	<u> </u>
<u> </u>	<u> </u>

Electric Log Run (Show type log and depths covered)

Dual Induction 1192-5968'
 Compensated Density 5450-5968'