

PLAT AND CERTIFICATION OF ACREAGE ATTRIBUTABLE TO A GAS WELL

State Corporation Commission, Conservation Division
245 North Water Wichita, Kansas 67202

OPERATOR Kennedy & Mitchell, Inc.

LOCATION OF WELL

LEASE WALKER

1980 feet from the SOUTH line
660 feet from the WEST line
Of the SW/4 of Sec. 35 T. 34 S. R. 26 W

WELL NUMBER #25-419

FIELD _____

COUNTY Meade


ORDER GRANTING ALLOWABLE ENTERED IN DOCKET NO. _____

NUMBER OF ACRES
ATTRIBUTABLE TO WELL 640

DESCRIPTION OF ACREAGE:

P L A T

(Show location of Well and outline attributable acreage)

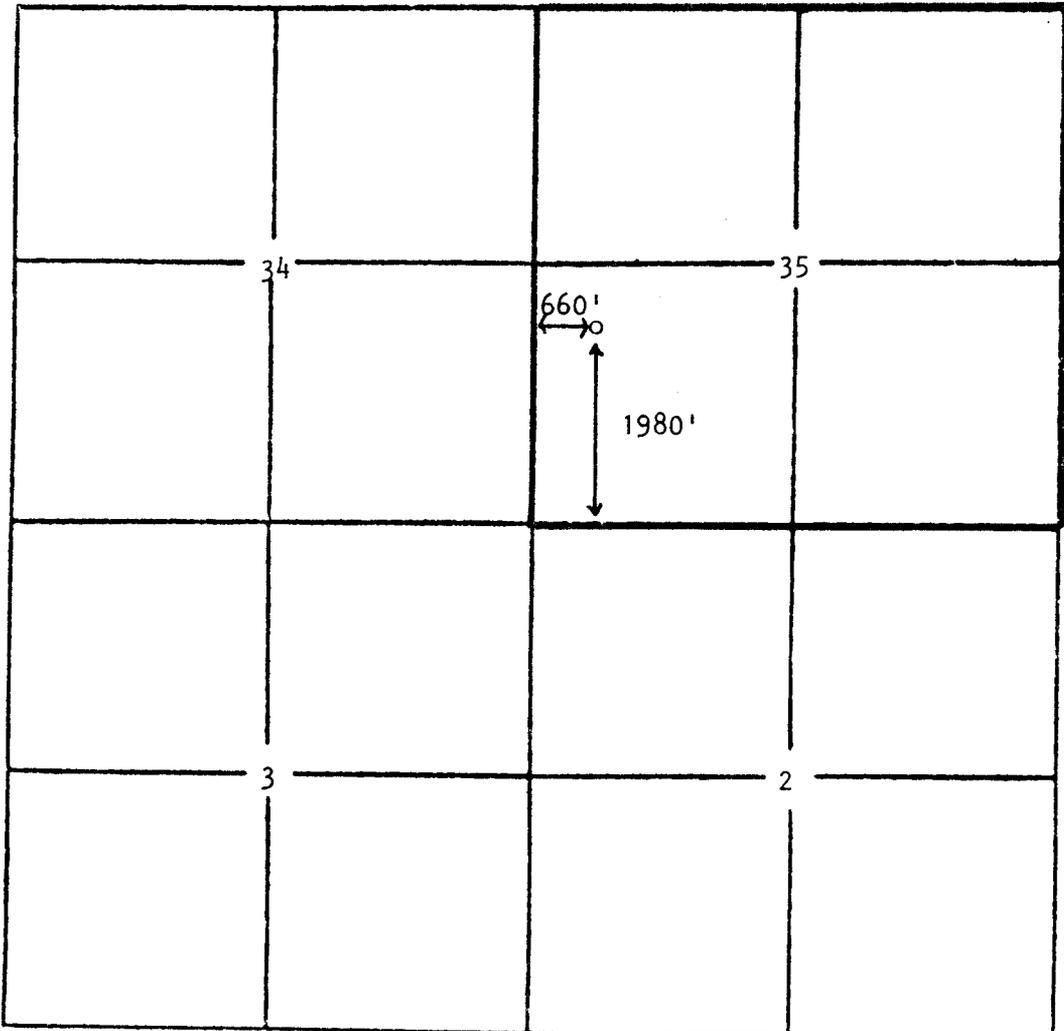

The undersigned hereby certifies that he is Ned E. Lowry
for KENNEDY & MITCHELL, INC., a duly authorized agent, that all information shown hereon is true and correct to the best of his knowledge and belief, and that all acreage claimed as attributable to the well named herein is held by product of F.F.B. that well