

Harper

KANSAS

SECTION 26 TOWNSHIP 34S RANGE 5W

WELL NO. #1 Baker

COMPANY Sunray Mid-Continent Oil Co.

NORTH

NE NE NW

			0				

WEST

EAST

SOUTH

HOT FILE Harper KANSAS

SEC. 26 TWP. 34 S R. 5 W

WELL NO. # 1 W. Baker FARM

COMPANY Sunray Mid-Continent (EXPLORATORY)

CONTRACTOR Stickle


Bluff Creek Fld. Area Wildcat

330 FT. FROM N. LINE

FT. FROM S. LINE

330 FT. FROM E. LINE

FT. FROM W. LINE

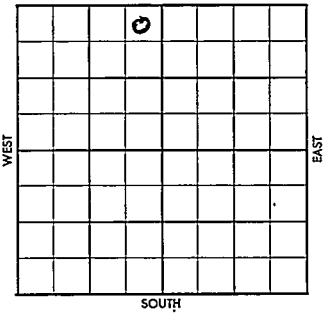

of NW/4
NE NE NW

ELEVATION	REPORT
1957	5000' Simpson Test
11/4	MIRT (DR#215)
11/5	RURT (FR Tkt)
11/6	Spudded 11-5-57 TD 281'. WOC. 8-5/8" @ 280'
11/7	Drlg. 340'
11/8	Drlg. 1350'
11/11	Drlg. 2545'
11/12	Drlg. 3010'
11/13	Drlg. 3240'
11/14	Drlg. 3560'
11/15	Drlg. 3814'
11/18	Drlg. 4100'
11/19	Drlg. 4263'
11/20	Drlg. 4424'
11/21	Drlg. 4495'
11/22	Drlg. 4565'
11/25	Drlg. 4697'
11/26	Drlg. 4741'
11/27	Drlg. 4800'
12/2	TD 4938' P & A (DR#233)

