

Well No. 1 Smith

NORTH

WEST

EAST

0

SOUTH

Summer		KANSAS	
SEC.	TWP.	R.	
26	34	1 W	✓

WELL NO. # 1 Smith FARM

COMPANY Herndon Drlg.

CONTRACTOR Herndon Drlg.
Wildcat

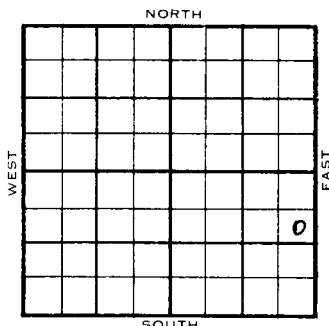
990 Ft. from N. Line

Ft. from S. Line

330 Ft. from E. Line

Ft. from W. Line

SE NE SE



	ELEVATION	REPORT
1954	1113'	

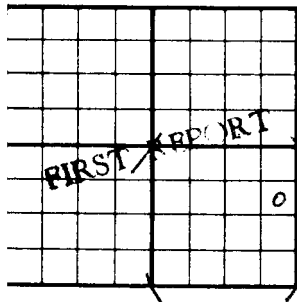
3/3 Spud 2-26-54
8" @ 324
Drlg. 1230'

3/10 Stal 2767', Lay 3159'
Drlg 3440'

3/17 DST 3545'-71' $\frac{1}{2}$ hr, 5' M NS Off
Miss 3874' NS. Simp 4237'
Drlg 4275'

3/24 Spud 2-26-54
D & A
TD 4416'
8" @ 324'
Stal. 2767', Layton 3159',
DST 3545'-71' opn $\frac{1}{2}$ hr, rec 5' Mud
Off Miss 3874', Simp 4237' Arb 4378'
TD 4416'
D & A

ABANDONED

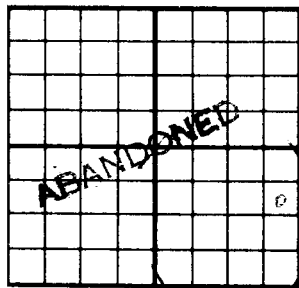
County **Sumner** State **Kansas**Sec. **26** (Blk.) **34** (Sur.) **1W** Map No.Operator **Herndon Drlg.**Well No. **1** Farm **Smith**Elev. Location **SE NE SE**990 Ft. From **N** Line **SE**330 Ft. From **E** Line Quarter1st. Report **MAR J**

Completion

Remarks

Herndon Drlg. - Contr.Spudding Date **2-26-54**Drlg. Data **Wildcat****8" @ 324 drlg. 1230**

G. MCGEEHEE

County Sumner State KansasSec. 26 (Blk. 34 (Sur. 1W Map No.)
(Twp.) (Rge.)Operator Herndon Drlg.Well No. 1 Farm SmithElev. 1113 Location SE NE SE990 Ft. From N Line SE330 Ft. From E Line Quarter1st. Report Completion MAR 24 1954Remarks WildcatHerndon Drlg. - Contr.Spudding Date 2-26-54Drlg. Data D & A TD 44168" @ 324 Stal. 2767 Layton 3159DST 3545-71 open $\frac{1}{2}$ hr. Rec. 5' mud0# Miss. 3874 Simp. 4237 Arb. 4378TD 4416D & A