

Barber

KANSAS


SECTION 26 TOWNSHIP 34 RANGE 13W

WELL NO. #1 Allen

COMPANY Aurora Gasoline & Nate Appleman

NORTH

G NE SW

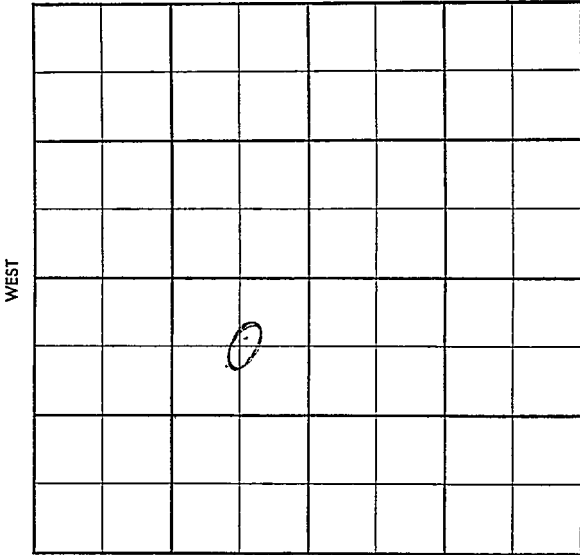

SOUTH

~~26~~

County Barber Elev. \_\_\_\_\_

Sec. 26 Twp. 34 Rge. 13W

Company Aurora Gasoline and Nate Appleman

Farm Name Allen No. 1

Co.

TOPS	DEPTH	LOG	DATUM	Loc. in Sec.
Anh.				C NE SW
Tr.				
Dg.				
Bl.				
L.				Geol. _____
K.C.				Contr. _____
B.K.C.				Barbour Tool
Ce.				
C.				Pool
M.				
K.				Elwood (Ext.)
Mz.				
Me.				<div data-bbox="699 1010 958 1319" data-label="Text"> <p>SEP 18 1931</p> <p>FIRST REPORT</p> </div>
V.				
S.				
S.				
A.				
R.				
PE.				
G.				
T.D.				

Use

LANO.

Date Comm. \_\_\_\_\_

Sec.

Location \_\_\_\_\_

T.

R.

County Barber Elev. 1490 DF  
 Sec. 26 Twp. 34 Rge. 13W  
 Company Aurora Gasoline and Nate Appleman  
 Farm Name Allen No. 1

TOPS	DEPTH	LOG	DATUM
Anh.			
Ip.			
H.			
Tr.			
Dg.			
Bl.			
L.			
K.C.			
B.K.C.			
Ce. <u>Elgin</u>	<u>3619</u>		
C. <u>Elgin sd</u>	<u>3630</u>		
M.			
M.			
K.			
Mz.			
Mo.			
V.			
S.			
S.			
A.			
R.			
PE.			
G.			
TD.	<u>3634</u>		

Loc. in Sec. C NE SW  
 Geol. \_\_\_\_\_  
 Contr. Barbour Tools  
 Pool Elwood (Ext.)

COMPLETE	
0	
OCT 23 '57	

Date Comm. \_\_\_\_\_  
 Location S 25 57 9-21-57 8' 257/225  
1935 OCT 2 '57 DST 3618-34  
2 hrs G 1/2 1/2 ga 1.790 MCF 115"  
2. MCF/30" net 37' 5 GCM  
FP 140-360 BHP 1440-1410/30"  
no log 5 1/2 3634/125 woc  
OCT 9 '57 MCT OCT 16 '57 DD 3635 1/2  
ga 3.500 MCF net  
250 A frac flo kd

ga 5.000 MCF = Pd 1" ch  
TP 920 CP 1000 2B fld ph  
5070W + 5090 dist

3. 27

ca OF 21, MCF + 3B wph  
+ Dist

elgin 3634-35 $\frac{1}{2}$