


Section26Township34Range11W

Well No.#1 McBrayer

CompanyDeep Rock

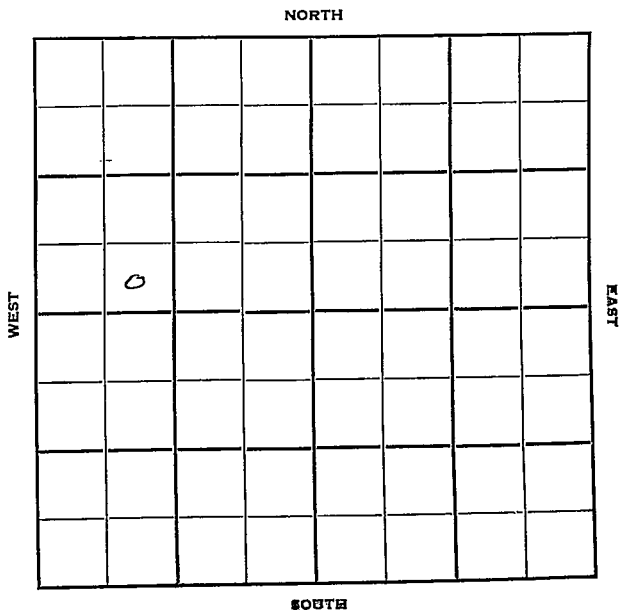

Barber

KANSAS

Sec. 26 Twp. 34 R. 14W

Well No. #1 McBrayer Farm ☒

Deep Rock Company

Coppinger - Contr. Contractor
Wildcat


 Ft. from N. Line

330' Ft. from S. Line

 Ft. from E. Line

990' Ft. from W. Line

SE SW NW

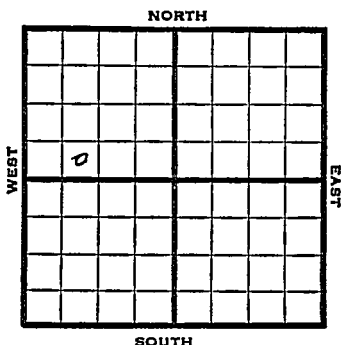

1951	Elev. 1571' REPORT
10/17	Spud 10-15-51 10" @ 305' WOC
12/5	Spud 10-15-51 D & A TD 5495' 10" @ 305' Elgin 3761' DST 3745-90' open 1 hr. rec 2985' SW Lans. 4138' B KC 4587' Miss 4738' DST 4740-80 open 75 min. rec 60' GCM DST 4785-4835 open 1 hr. rec 25' mud Kh. 4978' Arb. 5442' DST 5445-95 open 1 hr. rec 335' SW TD 5495' D & A ABANDONED

County **Barber** State **Kansas**
 Sec. **26** (Blk. Twp.) **34** (Sur. Rge.) **14W** Map No.

Operator **Deep Rock**

Well No. **1** Farm **Mc Brayer**

Elev. Location **SE SW NW**

FIRST				REPORT			

330 Ft. From **S** Line **NW**

990 Ft. From **W** Line Quarter

Ist. Report **OCT 17 1951**

Completion

Remarks **CRA - DEIM**


Coppinger - Contr.

Spudding Date **10-15-51**

Drlg. Data **Wildcat**

10" @ 305 W.O.C.

J. E. TYRA

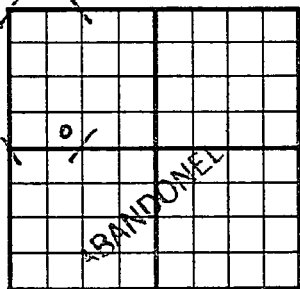County Barber State KansasSec. 26 (Blk.
Twp.) 34 (Sur.
Rge.) 14W Map No.Operator Deep RockWell No. 1 Farm McBrayerElev. 1571 Location SE SW NW330 Ft. From S Line NW990 Ft. From W Line Quarter

1st. Report

Completion DEC 5 1951Remarks WildcatCoppinger - Contr.Spudding Date 10-15-51Drilg. Data D & A TD 549510" @ 305 Elgin 3761 DST 3745-90open 1 hr. Rec. 2985' sw Lans. 4138B KC 4587 Miss. 4738 DST 4740-80open 75 min. Rec. 60' gcm DST 4785-4835open 1 hr. Rec. 25' mud Kh. 4978Arb. 5442 DST 5445-95 open 1 hr.Rec. 335' sw TD 5495D. & A

J. E. TYRA