


Section 26 Township 34S Range 26W

Well No. #1 G. L. Davidson

Company Skelly Oil Co.

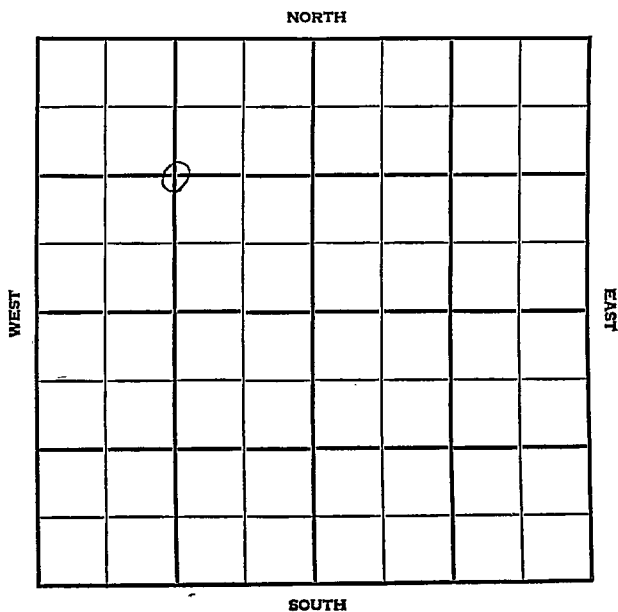

Meade

KANSAS

| | | |
|------------|-------------|-----------|
| SEC. 26 | TWP. 31S | R. 26W |
|------------|-------------|-----------|

WELL NO.

1 C. L. Davidson

FARM

COMPANY

Skelly Oil Co.

CONTRACTOR

Rine

McKinney


_____ FT. FROM N. LINE

_____ FT. FROM S. LINE

_____ FT. FROM E. LINE

_____ FT. FROM W. LINE

C NW/4

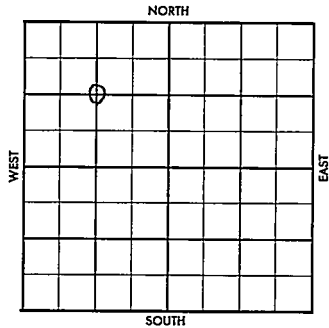

1956

ELEVATION

2188'

REPORT

6-20

Comm. 6-17-56
Drlg. 437'

8-15

Comm. 6-17-56
 13 3/8" @ 118 w/150
 8 5/8" @ 1200 w/500
 DST 5783-5844 op 90 min. gas to surf.
 6 min. ga 132 mcf in 75 min. rec. 120'
 GCM BHP 1910#.
 DST 5854-5910 op 1 hr., rec. 20' mud,
 BHP 75/20#
 DST 5914-20 op 30 min. rec. 5' mud,
 BHP 50#.
 5 1/2" @ 5970 w/250
 CO 5939; 48/5842-50
 SI 2 hrs.,
 ga 73 mcf; 60/5834-42; ga 124 mcf;
 36/5825-34; ga 140 MCF; ga 242 mcf;
 Frac; ga 1,710 mcf; SICP 1525#
 Tst 3 Mill CFG, CP 510#
 Cal op flw 3,134 MCFGPD
 L. 4578'; Marm 5278'; Ce. 5506';
 Mw. sh. 5798'; Mw. sd. 5825';
 Miss. 5864';
 Log tops: Mw. sh. 5790'; Miss 5870'
 TD 5970'

COMPLETED

County Moade Elev. _____
 Sec. 26 Twp. 34S Rgs. 26W
 Company Skelly Oil Co.
 Farm Name C. L. Davidson No. 1

| TOPS | DEPTH | LOG | DATUM | Loc. in Sec. | | | | | | | | | | | | | | | | | | | | | |
|--------|-------|-----|-------|---|--|--|--|--|--|--|--|--|--|--|--|--|--|--|--|--|--|--|--|--|--|
| Anh. | | | | C NW/4 | | | | | | | | | | | | | | | | | | | | | |
| TP. | | | | | | | | | | | | | | | | | | | | | | | | | |
| H. | | | | | | | | | | | | | | | | | | | | | | | | | |
| Tr. | | | | | | | | | | | | | | | | | | | | | | | | | |
| Dg. | | | | | | | | | | | | | | | | | | | | | | | | | |
| BL. | | | | | | | | | | | | | | | | | | | | | | | | | |
| L. | | | | Geol. _____ | | | | | | | | | | | | | | | | | | | | | |
| K.C. | | | | Contr. _____ | | | | | | | | | | | | | | | | | | | | | |
| B.K.C. | | | | | | | | | | | | | | | | | | | | | | | | | |
| Ce. | | | | | | | | | | | | | | | | | | | | | | | | | |
| C. | | | | Rine | | | | | | | | | | | | | | | | | | | | | |
| M. | | | | Pool | | | | | | | | | | | | | | | | | | | | | |
| M. | | | | | | | | | | | | | | | | | | | | | | | | | |
| K. | | | | | | | | | | | | | | | | | | | | | | | | | |
| Mz. | | | | McKinney | | | | | | | | | | | | | | | | | | | | | |
| Mq. | | | | <table border="1"> <tr> <td></td> <td></td> <td></td> </tr> <tr> <td></td> <td></td> <td></td> </tr> <tr> <td></td> <td></td> <td></td> </tr> <tr> <td></td> <td></td> <td></td> </tr> <tr> <td></td> <td></td> <td></td> </tr> <tr> <td></td> <td></td> <td></td> </tr> <tr> <td></td> <td></td> <td></td> </tr> </table> | | | | | | | | | | | | | | | | | | | | | |
| | | | | | | | | | | | | | | | | | | | | | | | | | |
| | | | | | | | | | | | | | | | | | | | | | | | | | |
| V. | | | | | | | | | | | | | | | | | | | | | | | | | |
| S. | | | | | | | | | | | | | | | | | | | | | | | | | |
| S. | | | | | | | | | | | | | | | | | | | | | | | | | |
| A. | | | | | | | | | | | | | | | | | | | | | | | | | |
| R. | | | | | | | | | | | | | | | | | | | | | | | | | |
| PE. | | | | | | | | | | | | | | | | | | | | | | | | | |
| G. | | | | | | | | | | | | | | | | | | | | | | | | | |
| T.D. | | | | | | | | | | | | | | | | | | | | | | | | | |

Date Comm. 6/17/56
D 437

JUN 20 '56

[Handwritten signature and scribbles]

[Handwritten notes and scribbles]

Co.
Lse.
No.
Sec.
T.
R.

County Maude Elev. 2188
 Sec. 26 Twp. 31S Rge. 26W
 Company Skelly Oil Co.
 Farm Name C. L. Davidson No. 1

| TOPS | DEPTH | LOG | DATUM | Loc in Sec. | | | | | | | | | | | | | | | | |
|--------|-------------|-------------|-------------|---|--|--|--|--|--|--|--|--|--|--|--|--|--|--|--|--|
| Anh. | | | | C NW 1/4 | | | | | | | | | | | | | | | | |
| Ip. | | | | | | | | | | | | | | | | | | | | |
| H. | | | | | | | | | | | | | | | | | | | | |
| Tr. | | | | | | | | | | | | | | | | | | | | |
| Dg. | | | | | | | | | | | | | | | | | | | | |
| Bl. | | | | | | | | | | | | | | | | | | | | |
| L. | <u>4578</u> | | | Geol. | | | | | | | | | | | | | | | | |
| K.C. | | | | Contr. | | | | | | | | | | | | | | | | |
| B.K.C. | | | | Rine | | | | | | | | | | | | | | | | |
| Ce. | | | | Pool | | | | | | | | | | | | | | | | |
| C. | | | | McKinney | | | | | | | | | | | | | | | | |
| M. ACM | <u>5278</u> | | | <table border="1"> <tr> <td></td> <td></td> <td></td> <td></td> </tr> <tr> <td></td> <td></td> <td></td> <td></td> </tr> <tr> <td></td> <td></td> <td></td> <td></td> </tr> <tr> <td></td> <td></td> <td></td> <td></td> </tr> </table> | | | | | | | | | | | | | | | | |
| | | | | | | | | | | | | | | | | | | | | |
| | | | | | | | | | | | | | | | | | | | | |
| | | | | | | | | | | | | | | | | | | | | |
| | | | | | | | | | | | | | | | | | | | | |
| M. CE | <u>5506</u> | | | | | | | | | | | | | | | | | | | |
| K. | | | | | | | | | | | | | | | | | | | | |
| Mz. | <u>Mush</u> | <u>5798</u> | <u>5790</u> | | | | | | | | | | | | | | | | | |
| Ms. | <u>" sd</u> | <u>5825</u> | | | | | | | | | | | | | | | | | | |
| V. | <u>Mis</u> | <u>5864</u> | <u>5870</u> | | | | | | | | | | | | | | | | | |
| S. | | | | | | | | | | | | | | | | | | | | |
| S. | | | | | | | | | | | | | | | | | | | | |
| A. | | | | | | | | | | | | | | | | | | | | |
| R. | | | | | | | | | | | | | | | | | | | | |
| PE. | | | | | | | | | | | | | | | | | | | | |
| G. | | | | | | | | | | | | | | | | | | | | |
| TD. | <u>5970</u> | | | COMPLETE | | | | | | | | | | | | | | | | |

Date Comm. 6/17/56 AUG 15 '56
 D 137 JUN 27 '56 13 3/8 118/150
 852 1200/500 ϕ 3188 JUL 3 '56
 ϕ 3260 JUL 11 '56 ϕ 5510 JUL 18 '56
 DST 5783-5844 ϕ 90" 9 to 5. 6"
 ga. 132 MCF in 75" acc. 120' ACM
 BHP 1910 ϕ 5910 DST 5854-5910
 ϕ 1hr acc 20' Md BHP 75/20
 ϕ ahead JUL 25 '56 DST 5914-20 30"
 acc 5' Md BHP 50 5 1/2 @ 5970/250

CO 5939 48/5842-50 N.S. S.I.

2 hrs 9a 73 MCF 60/5834-42

9a 124 MCF 36/5825-34 9a

140 MCF ~~8/14~~ 9a 242 MCF

AUG 14 '56 FRC 9a 1,710 MCF

51CP 1525# AUG 18 '56 +57 3

MILL CFC CP 510

AUG 15 '56

CAL UP FLW 3,134

MCFGRD