

Seward

Section 26 Township 34 Range 34W


Well No. #1 Green

Company Hugoton Prod. & Plains Exploration

NORTH

WEST

EAST

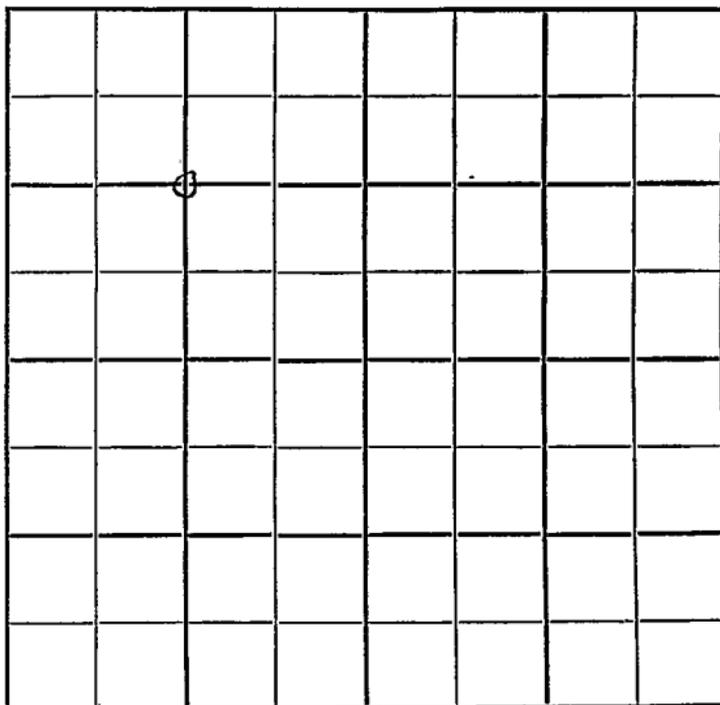

SOUTH

Seward

KANSAS

Sec. 26

Twp.

34

R.

34W ✓

Well No. #1 Green

Farm

Hugoton Prod. & Plains Exploration

Company

Contractor

1320' Hugoton Pool


Ft. from N. Line

Ft. from S. Line

Ft. from E. Line

1320' Ft. from W. Line

C NW/4

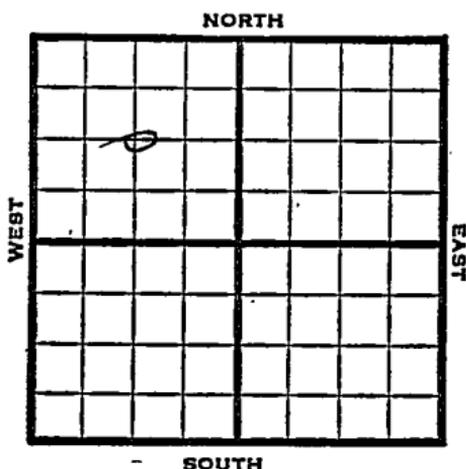

1951

Elev. 2910'

REPORT

2/28

Location

6/26

Spud 3-4-51 Gas well TD 2712'  
 10" @ 667 7" @ 2711 TD 2712'  
 Hol. 2576' Her 2637' Krider 2664'  
 90/2695-2710 30/2683-88  
 60/2670-80 78/2646-59 30/2637-42  
 13,750 A  
 Comp. 990,000 gas

**COMPLETED**


County Seward State Kansas

Sec. 26 (Blk. 34) (Sur. 34W) Map No.

Operator Hugoton Prod. & Plains Exploration

Well No. 1 Farm Green

Elev. 2910 Location C NW/4

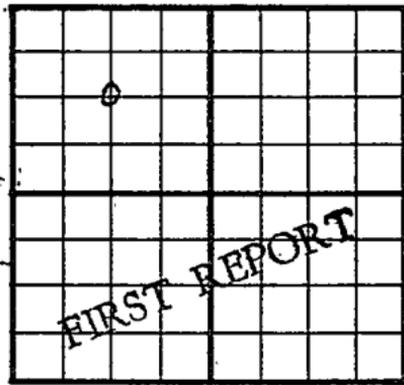

1320 Ft. From N Line NW

1320 Ft. From W Line Quarter

Ist. Report FEB 28 1951

Completion \_\_\_\_\_

Remarks \_\_\_\_\_

Spudding Date \_\_\_\_\_

Drig. Data Hugoton Pool

Location

J. E. TYRA

