

Morton


KANSAS

DX 78-1

Section 26 Township 34 Range 43W

Well No. 1 Kansas

Company Panhandle Eastern

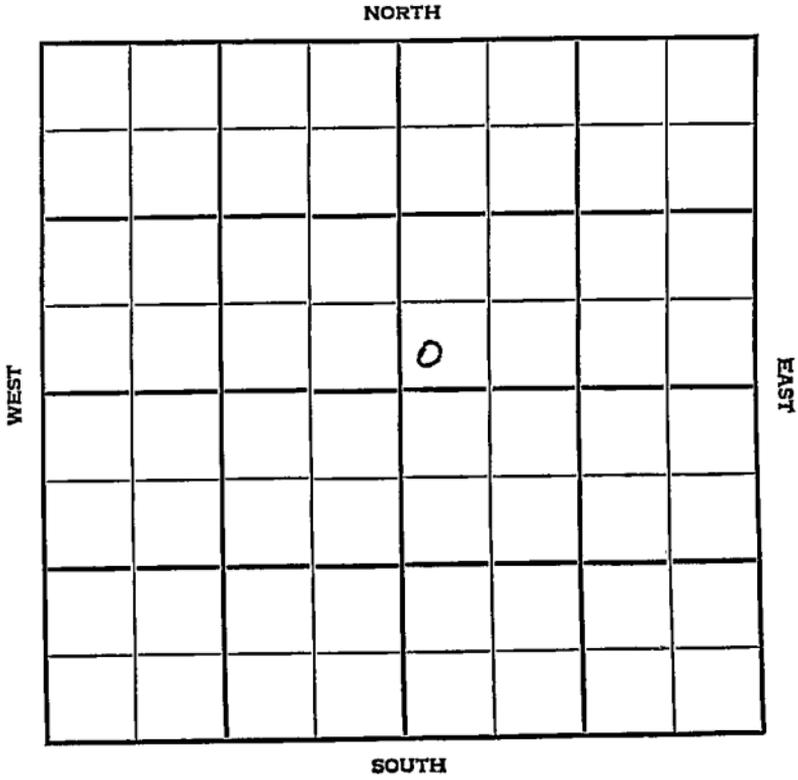

SEC.	26	TWP.	34	R.	43W
------	----	------	----	----	-----

WELL NO. #1 Kansas FARM

COMPANY Panhandle Eastern

CONTRACTOR Falcon-Seaboard  
Greenwood


2350 Ft. from N. Line

Ft. from S. Line

2440 Ft. from E. Line

Ft. from W. Line

SW SW NE

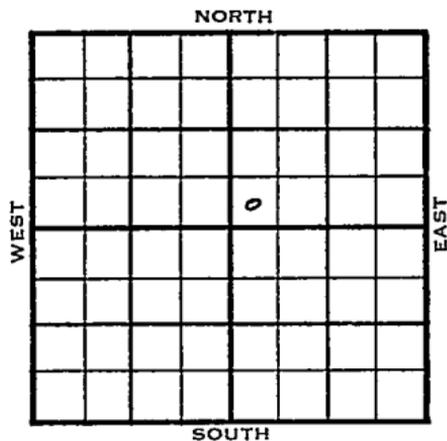

	ELEVATION	REPORT
1955	3506'	

7/27 ~~Fr~~ Comm 7-24-55

9/28 Comm 7-24-55  
 10" @ 601 w/350  
 7" @ 3061' w/  
 Tp 2767  
 L 3000  
 40/3009-19 no gas 75 to 90 gwph 24/  
 2956-62 1000 acid 20 gwph Plus 2930  
 24/2910-16 12/2895-98 40/2883-93  
 16/2876-80 no show 1000 acid 24/2845  
 -50 no show aq CO 40/3818-28 no show  
 64/2798-2814 no gas 12 gwph 500 acid  
 SQ plug 135 gwph sq Pf 2774-80  
 2755-67 no show 1000 acid no show  
 hole full wtr sqzd FP 2740-45 2732-  
 37 2716-26 2708-12 no show  
 1000 Acid no show full wtr  
 D & A

**ABANDONED**

County Morton Elev. \_\_\_\_\_  
 Sec. 26 Twp. 34 Rge. 43W  
 Company Panhandle Eastern  
 FarmName Kansas No. 1

TOPS	DEPTH	LOG	DATUM	Loc. in Sec.
Anh.				SW SW NE
TP.				2350' NL
H.				2440' EL
Tr.				
Dg.				
Bl.				
L.				Geol. _____
K.C.				Contr. _____
B.K.C.				Falcon-Seaboard
Ce.				Pool _____
C.				Greenwood
M.				
M.				
K.				
Mz.				
Me.				
V.				
S.				
S.				
A.				
R.				
PE.				
G.				
T.D.				

FIRST REPORT  
 JUL 27 55

Date Comm. 7-24-55

*[Handwritten signature]*

Co.  
 L.S.  
 No.  
 Sec.  
 T.  
 R.

JUL 29 1955

✓	Scout Cards	<i>mmc</i>	_____
	Land Small Map		_____
	Land Wall Map		_____
✓	Tracings		_____
	France Map		_____
	Pierce Map		_____
	Misc.		_____

County Morton Elev. 3506  
 Sec. 26 Twp. 34 Rge. 43W  
 Company Panhandle Eastern  
 FarmName Kansas No. 1

Co.

TOPS	DEPTH	LOG	DATUM
------	-------	-----	-------

Loc. in Sec.

Anh.			
TP.	<u>2767</u>		
H.			
Tr.			
Dg.			
Bl.			
L.	<u>3000</u>		
K.C.			
B.K.C.			
Ce.			
C.			
M.			
M.			
K.			
Mz.			
Me.			
V.			
S.			
S.			
A.			
R.			
PE.			
G.			
T.D.	<u>3065</u>		

SW SW NE

Geol.

Contr.

Falcon-Seaboard

Pool

Greenwood

	0	

**ABANDONED**

15

No.

Sec.

Date Comm. 7/24/55

SEP 28 1955

10" 601 w/350 7" 3061 40/3009-19 no gas  
 75 to 90 gwph 24/2956-62 1000 Acid 20 gwph  
 Plus 2930 24/2910-16 12/2895-98 40/2883-93  
 16/2876-80 no show 1000 Acid 24/2845-50  
 no show sq CO 40/3818-28 no show 64/2798-  
 2814 no gas 12 gwph 500 Acid S.O. plug  
 135 gwph sq. Pf 2774-80 2755-67 no show  
 1000 Acid no show hole full wtr sqd  
 FP 2740-45 2732-37 2716226 2708-12 no show

**OVER**

R.

OCT 6 1955

Scout Cards	<i>m/m</i>
Land Small Map	_____
Land Wall Map	_____
Tracings	_____
France Map	_____
Pierce Map	_____
Misc.	_____

D & A

1000 Acid no show full wtr