

Section 26 Township 34 Range 41WWell No. #1 StanfordCompany Cities Service Oil

NORTH

				0			

WEST

EAST

SOUTH

Morton

KANSAS

Sec. 26 Twp. 34 R. 41W

Well No. #1 Stanford Farm

Cities Service Oil Company

Barbour Contractor
Hugoton


100' Ft. from N. Line

Ft. from S. Line

Ft. from E. Line

100' Ft. from W. Line

NW NW SE

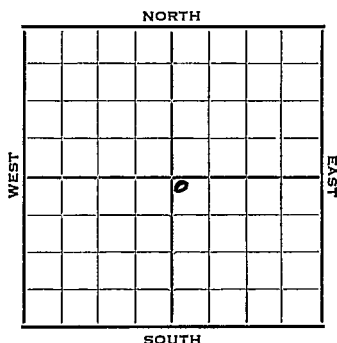

1952

Elev. 3105'

REPORT

2/13

Spud 2-11-52
8" @ 320

WOC

2/20

TD 2430 5" @ 2429
Upper Krider 2320 Winfield 2364

3/5

8000 A Gauge 2,330,000 gas

3/12

NR

3/19

Spud 2-11-52
Gas well TD 2430' 8" @ 320
5" @ 2429 TD 2430' Kri 2300'
Win 2364' 40/2378-86 20/2372-76
20/2366-70 4000 A 60/2332-44
30/2322-28 20/2302-16 2000 A
8000 A
Comp. 7,830,000 gas

COMPLETED

County Morton State Kansas
 Sec. 26 (Blk. 34 (Sur. 41W Map No.)
 Operator Cities Service Oil
 Well No. 1 Farm Stanford
 Elev. Location NW NW SE

FIRST REPORT

100 Ft. From N Line SE
100 Ft. From W Line Quarter
 1st. Report FEB 13 1952

Completion

Remarks

Barbour - Contr.

Spudding Date 2-11-52


Hugoton

Drlg. Data

8" @ 320 W.GC.

J. G. McGEHEE

County Morton State Kansas
 Sec. 26 (Blk. Twp.) 34 (Sur. Rge.) 41W Map No. _____
 Operator Cities Service Oil
 Well No. 1 Farm Stanford
 Elev. 3405 Location NW NW SE

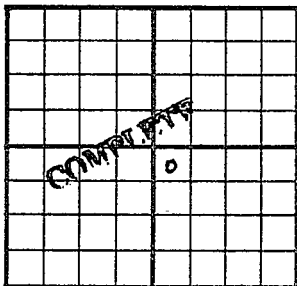

100 Ft. From N Line SE
100 Ft. From W Line Quarter
 1st. Report _____
 Completion MAR 19 1952
 Remarks Hugot on Pool
Barbour - Contr.
 Spudding Date 2-11-52

Drlg. Data Gas well TD 2430
8" @ 320 5" @ 2429 TD 2430
Kri. 2300 Win. 2364 40/ 2378-86
20/ 2372-76 20/ 2366-70 4000 A
60/ 2332-44 30/ 2322-28 20/ 2302-16
2000 A 8000 A 14000
Comp. 7,830,000 gas

J. G. McGEHEE