


KANSAS Stevens

FORM 51 5M PETROL

Section 26 Township 34 Range 38-W

Well No. #1 A. Burrlows

Company Republic Natural Gas

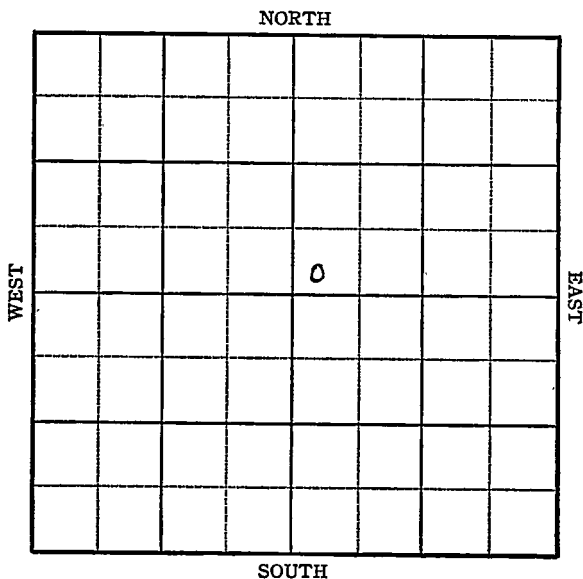


Sec. 26 Twp. 34 R. 38WWell No. #1 A. Burrlows FarmRepublic Natural Gas Company

Hugoton

 Ft. from N. Line200 Ft. from S. Line Ft. from E. Line200 Ft. from W. Line

SW NE

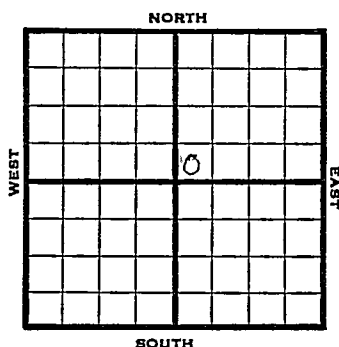

1946 Elev. 3186 REPORT

3/13	Location
3/21	R.U.R.
3/28	10" - 678'
	Drlg. 1200'
4/4	TD 2622
	7" @ 2614 RUST
4/10	Drlg 2840
4/16	TD 2845 259' of 5"
	Perf liner @ 2845 5 M Gas
4/23	" " "
5/1	" " "
5/7	" " "
5/14	" " "
5/21	" " "
5/29	" " "
6/5	" " "
6/12	" " "
6/18	" " "
6/26	12500 acid
7/3	" "
7/10	7" @ 2614
	259' of 5" perf. liner @ 2845
	12,500 acid.
	TD 2845
	33,607,000 Gas.
	395# R Pr.

COMPLETED

KANSAS

Kansas

Pool Name HugotonMap No. Map Sec. 26 Twp. 34 R. 38WWell No. 1 A, Burrlows


Republic Natural Gas

Company

FIRST REPORT

Contractor

SW NE

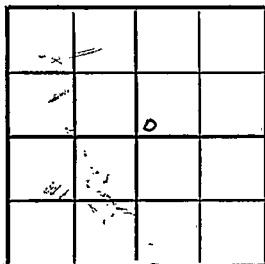SECTION PLAT

Ft. from N. Line

200 Ft. from S. Line

Ft. from E. Line

200 Ft. from W. LineStevens CountyLocation X

Rig up

Drilling and Remarks:

RECORDCased in, ft.

Sand

Gas

Oil

Total Depth

PRODUCTION1st 24 hrs. Nat. 1st 24 hrs. after shot Gas Cu. Ft.Dry Hole Abandoned

Date

MAR 13 1946 19S. J. LEWIS Scout

Misc. Small Maps

Cards

Tracing

France Map

Scarborough Map

Pierce Map

Ceological Dept.


Plat Book

KANSAS

Kansas Pool Name Hugoton PoolMap No. No Map Sec. 26 Twp. 34 R. 38WWell No. 1 A. BurrlowsRepublic Natural Gas Company**COMPLETED**

Contractor

SW NE

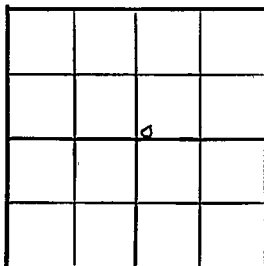E 13186
SECTION PLAT Ft. from N. Line200 Ft. from S. Line Ft. from E. Line200 Ft. from W. LineStevens CountyLocation Rig up Drilling and Remarks: 7" @ 2614259' of 5" Ref. line@ 284512580 sand33,607,000 Gas285 * R P**RECORD**Cased in. ft.Sand Gas Oil Total Depth 2845**PRODUCTION**1st 24 hrs. Nat. 1st 24 hrs. after shot Gas Cu. Ft.Dry Hole Abandoned 1"

Date

JUL 10 1946 19S. J. LEWIS

Scout

6-24

no *Travel*

Misc. Small Maps	<i>[initials]</i>
Cards	<i>Leralty</i>
Tracing	<i>[checkmark]</i>
France Map	<i>[checkmark]</i>
Scarborough Map	<i>A</i>
Pierce Map	<i>[checkmark]</i>
Geological Dept.	
Pierce Plat Book	