
FORM 51 5M 11-44 PETROL KANSAS Stevens County

Section 26 Township 34 Range 39W

Well No. #1 Cox

Company Harrington & Marsh

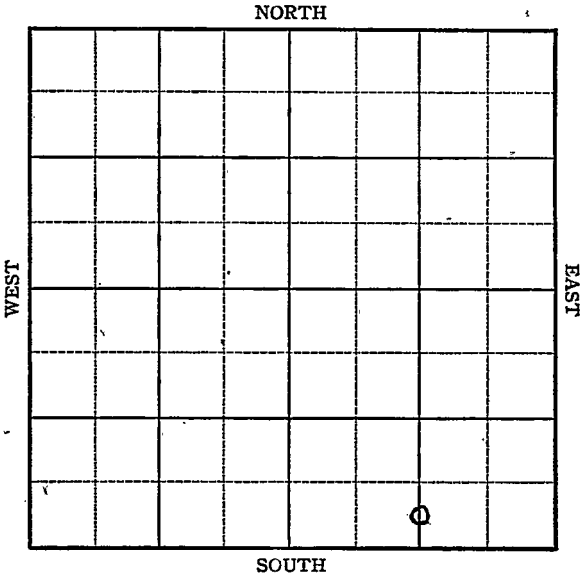

FORM 252-A
5M 6-46 PETROL

KANSAS Stevens County

Sec. 26 Twp. 34 R. 39W

Well No. #1 Cox Farm

Harrington & Marsh Company

Hugoton


_____ Ft. from N. Line

330 Ft. from S. Line

_____ Ft. from E. Line

1320 Ft. from W. Line

CSL S/2 SE

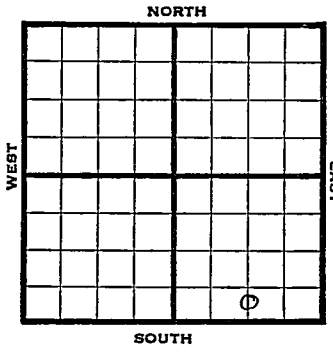

1946	REPORT Elev. 3297'
6/26	Location
7/3	"
7/9	"
7/16	"
7/23	"
7/30	"
8/6	Drlg 2300'
8/13	TD 2640' 7" @ 2634 Drlg 2650'
8/20	" "
8/27	TD 2789' 166' of 5" Perf liner @ 2789' 15000 acid
9/5	" " " "
9/10	" " " "
9/18	7" @ 2634' 166' of 5" Perf. liner @ 2789' TD 2789' Acid 15,000 Gas 32,400,000 RpR 366#

COMPLETED

FORM 26 200 BKS 2-44 PETROL

KANSAS Kansas Pool Name Hugoton

Map No. No map Sec. 26 Twp. 34 R. 39W


Well No. 1 Cox

Harrington & Marsh Company

FIRST REPORT Contractor

C S L S½ SE

SECTION PLAT

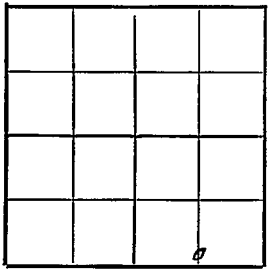

____ Ft. from N. Line

330 Ft. from S. Line

____ Ft. from E. Line

1320 Ft. from W. Line

Stevens County

Location X

Rig up

Drilling and Remarks:

RECORD

Cased ____ in., ____ ft.

Sand

Gas

Oil

Total Depth

PRODUCTION

1st 24 hrs. Nat.

1st 24 hrs. after shot

Gas ____ Cu. Ft.

Dry Hole

Abandoned

Date

JUN 26 1946 19 S. J. LEWIS Scout

FORM 26 200 BKS. 2-44 PETROL

KANSAS Kansas Pool Name Hugoton Pool

Map No. Sec. 26 Twp. 34 R. 39W

Well No. 1 Cox


Harrington & Marsh Company

COMPLETED Contractor

C S L S½ Sec.

E 1.3287

SECTION PLAT

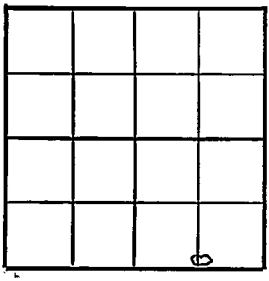

Ft. from N. Line

330 Ft. from S. Line

1320 Ft. from E. Line

Ft. from W. Line

Stevens County

Location

Rig up

Drilling and Remarks:

7" @ 2634

166' of 5" Perf liner @ 2789

15000 Acid

23,400,000 Gas

366 RP

RECORD

Cased in, ft.

Sand

Gas

Oil

Total Depth 2787

PRODUCTION

1st 24 hrs. Nat.

1st 24 hrs. after shot

Gas Cu. Ft.

Dry Hole

Abandoned

Date

SEP 1 8 1946 19 S. J. LEWIS Scout