

STATE CORPORATION COMMISSION OF KANSAS  
OIL & GAS CONSERVATION DIVISION  
WELL COMPLETION OR RECOMPLETION FORM  
ACO-1 WELL HISTORY  
DESCRIPTION OF WELL AND LEASE

Operator: License # 5181  
Name Donald C. Slawson  
Address Suite 700, 20 N. Broadway  
City/State/Zip Oklahoma City, OK 73102

Purchaser N/A

Operator Contact Person Daniel G. Wilson  
Phone 405/232-0201

Contractor: License # 5657  
Name Slawson Drilling Company, Inc

Wellsite Geologist Ed Heshner  
Phone 806/374-5256

Designate Type of Completion

New Well  Re-Entry  Workover  
 Oil  SWD  Temp Abd  
 Gas  Inj  Delayed Comp.  
 Dry  Other (Core, Water Supply etc.)

If ONNO: old well info as follows:

Operator  
Well Name  
Comp. Date Old Total Depth

WELL HISTORY

Drilling Method:

Mud Rotary  Air Rotary  Cable

03/30/87 4/10/87 4/12/87  
Spud Date Date Reached TD Completion Date

6,200 N/A  
Total Depth PBTD

Amount of Surface Pipe Set and Cemented at 1558 feet  
Multiple Stage Cementing Collar Used? Yes  No  
If yes, show depth set feet  
If alternate 2 completion, cement circulated from feet depth to w/ SX cmt  
Cement Company Name  
Invoice #

API NO. 15-119-20,756

County Meade

C NE Sec 1 Twp 34 Rge 27 East  
..... West

3983 Ft North from Southeast Corner of Section  
1320 Ft West from Southeast Corner of Section  
(Note: Locate well in section plat below)


Lease Name FRIESEN Well # 1-1

Field Name N/A

Producing Formation N/A

Elevation: Ground 2451 KB 2457

Section Plat

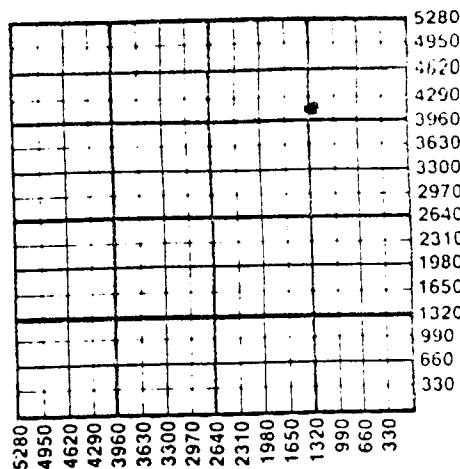

WATER SUPPLY INFORMATION

Disposition of Produced Water:  Disposal  
Docket #  Repressuring

Questions on this portion of the ACO-1 call:  
Water Resources Board (913) 296-3717

Source of Water:  
Division of Water Resources Permit #

Groundwater Ft North from Southeast Corner  
(Well) Ft West from Southeast Corner of  
Sec Twp Rge East West

Surface Water Ft North from Southeast Corner  
(Stream, pond etc) Ft West from Southeast Corner  
Sec Twp Rge East West

Other (explain)  
(purchased from city, R.W.D. #)

INSTRUCTIONS: This form shall be completed in triplicate and filed with the Kansas Corporation Commission, 200 Colorado Derby Building, Wichita, Kansas 67202, within 120 days of the spud date of any well. Rule 82-3-130, 82-3-107 and 82-3-106 apply. Information on side two of this form will be held confidential for a period of 12 months if requested in writing and submitted with the form. See rule 82-3-107 for confidentiality in excess of 12 months. One copy of all wireline logs and drillers time log shall be attached with this form. Submit CP-4 form with all plugged wells. Submit CP-111 form with all temporarily abandoned wells.

Operator Name Donald C. Slawson Lease Name FRIESEN Well # 1-1

Sec. 1 Twp. 34S Rge. 27  East  West County Meade

WELL LOG

INSTRUCTIONS: Show important tops and base of formations penetrated. Detail all cores. Report all drill stem tests giving interval tested, time tool open and closed, flowing and shut-in pressures, whether shut-in pressure reached static level, hydrostatic pressures, bottom hole temperature, fluid recovery, and flow rates if gas to surface during test. Attach extra sheet if more space is needed. Attach copy of log.

Drill Stem Tests Taken  Yes  No  
 Samples Sent to Geological Survey  Yes  No  
 Cores Taken  Yes  No

Formation Description  
 Log  Sample

Name	Top	Bottom
Chase Group	2,663	
Heebner	4,560	
Toronto	4,586	
Lansing	4,732	
Morrow	5,802	
Chester	5,900	

CASING RECORD  New  Used  
 Report all strings set-conductor, surface, intermediate, production, etc.

Purpose of String	Size Hole Drilled	Size Casing Set (in O.D.)	Weight Lbs/Ft.	Setting Depth	Type of Cement	#Sacks Used	Type and Percent Additives
Surface	11	3-5/8	24	1,558	Cl C Lite	500	3% CC
					Cl C	100	3% CC

Shots Per Foot	Specify Footage of Each Interval Perforated	Acid, Fracture, Shot, Cement Squeeze Record (Amount and Kind of Material Used)	Depth
	none		

TUBING RECORD Size none Set At Packer at Liner Run  Yes  No

Date of First Production Producing Method  Flowing  Pumping  Gas Lift  Other (explain).....