Barber


DX 78-1

KANSAS

Section 27 Township 34 Range 15W

Well No. #1 Ballet

Company Wm. Gruenerwald

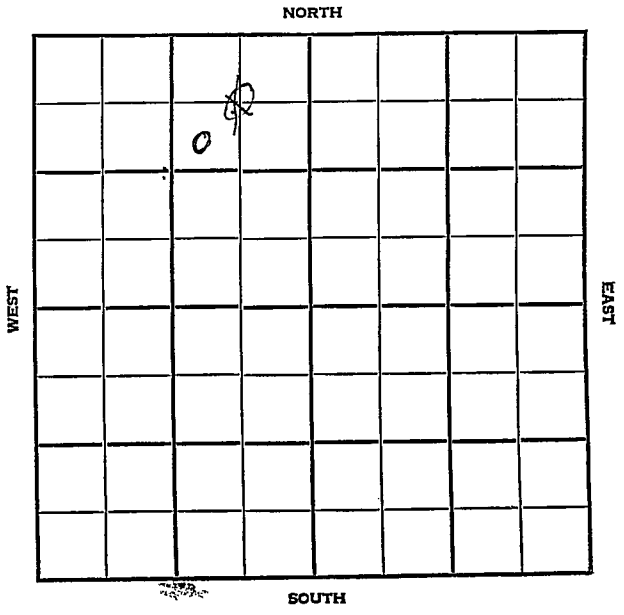

WILDCAT

FORM 513 SUNRAY

County Barber Elev.

Sec. 27 Twp. 34 Rge. 15W

Company Wm. Gruenwald

Farm Name Ballet No. 1


TOPS	DEPTH	LOG	DATUM
Anh.			
T.P.			
H.			
Tr.			
Dg.			
Bl.			
L.			
K.C.			
B.K.C.			
Ce.			
C.			
M.			
M.			
K.			
Mz.			
Mq.			
V.			
S.			
S.			
A			
R.			
P€.			
G.			
T.D.			

Loc. in Sec. C NE NW

Geol.

Contr. Patton Tools

Pool Wildcat

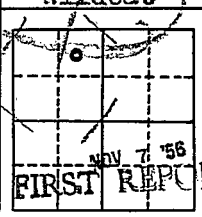

Date Comm. Champlin (DHM)

Location, RUR

Co. Lse. No. Sec. T. R.

CORRECTION

FORM 515 SUNRAY

County Barber Elev. 1551

Sec. 27 Twp. 34 Rge. 15W

Company Wm. Gruenerwald

Farm Name Ballet No. 1


TOPS	DEPTH	LOG	DATUM
Anh.			
Tp. Elgin	3726	3728	
H.	3920	3921	
Tr.	3933	3935	
Dg. Sh	3949	3951	
Bl.			
L.	4125	4126	
K.C.			
B.K.C.			
Ce.	4725		
C.			
M.	4740	4740	-3159
M. Redsh		5026	
K. LI	5061	5068	-3510
Mm Chats	5100	5100	
Mo.			
V.	5141	5140	
S.	5315	5314	
S. Sd	5330-41		
A	5452	5452	
R.			
Pe.			
G.			
T.D.	5500	5501	

Loc. in Sec. C NE NW SW NE NW

Geol.

Contr. Patton Tools

Pool Wildcat

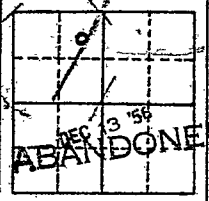

Date Comm. Champlin (DHM)

Location, RUR NOV 13 '58 11-7-58

13" @ 75/100 878 824/400

ℙ 2195 NOV 21 '58 ℙ 3779 NOV 28 '58

ℙ 4685 DEC 5 '58 DST 4711-73"

90" rec 90' OCM FP 0 BHP

90/20" DST 4778-4805 op 90"

rec 90' md 55/20" ℙ 5239

DEC 12 '58

DEQ