


SECTION 27 TOWNSHIP 34 RANGE 26W

WELL NO. #1 Taylor

COMPANY Skelly Oil Co.

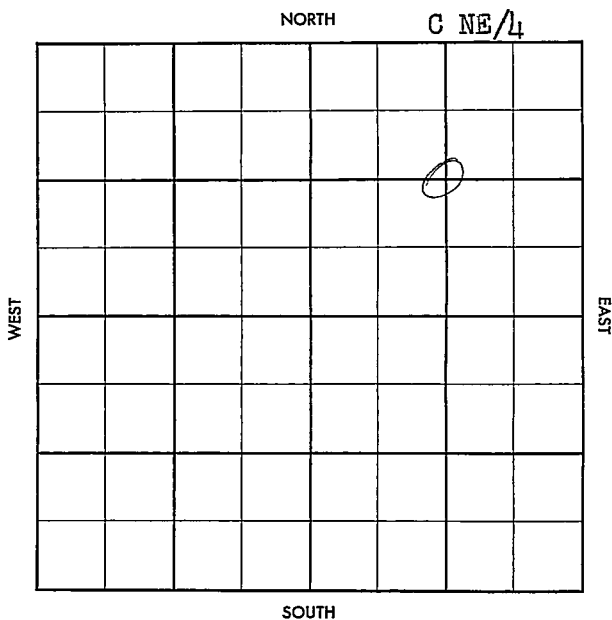

County Meade Elev. _____
 Sec. 27 Twp. 34 Rge. 26W
 Company Skelly Oil Co.
 Farm Name Taylor No. 1

TOPS	DEPTH	LOG	DATUM	Loc. in Sec.
Anh.				C NE/4
Tr.				
H.				
Tr.				1250' fml x
Dg.				1250' fel
BL.				
L.				Geol.
K.C.				Contr.
B.K.C.				
Ce.				
C.				
M.				
M.				Pool
K.				McKinney
Mz.				
Me.				
V.				
S.				
S.				
A.				
R.				
Pe.				
G.				
TD.				

Date Comm. Sinclair Oil (1/4 int)
 Location _____

3/5

County Meade Elev. 2247
 Sec. 27 Twp. 34 Rge. 26W
 Company Skelly Oil Co.
 Farm Name Taylor No. 1

TOPS	DEPTH	LOG	DATUM	Loc. in Sec.
Anh. <u>#</u>				C NE/4
Tr.				
H.	<u>4481</u>			1250' fml x
Tr.				1250' fel or 2' x
Dg.				
Bl.				
L.	<u>4645</u>			Geol.
K.C.				Contr.
R.K.C. <u>Marm</u>	<u>5350</u>			
Ce.	<u>5542</u>			
C.				
M.	<u>MW</u>	<u>5851</u>		
M.	<u>MW 5d</u>	<u>5887-5913</u>		Pool
K.				
Mz.	<u>M155</u>	<u>5947</u>		McKinney
Mo.				
V.				
S.				
S.				
A.				
R.				
PE.				
G.				
TD.	<u>6050</u>			

11	31	57
COMPLETE		

Date Comm. Sinclair Oil (1/4 int)

Location JUN 5 '57 RUR JUN 12 '57

6-3-57 858 895/550

11 2275 JUN 19 '57 11 3775 JUN 20 '57

11 5185 JUL 3 '57 11 5834 JUL 10 '57

ced 5882-5917 Full rec. DST

5885-5917 1 in 6/20" rec 10' Md

FP 20-20 BHP 1935/30" DST

5917-78 1 in rec 20' Md FP 20-20

BHP 50/20" DST 5983-6050 TD

1 hr ga 270 MCFG see
 100' MD FP 60-60 DHP 985/20"
 Rm 9 5 1/2 @ 6050 JUL 17 '57 CO 6013
 48/5992-98 24/6002-08
 ga 230 MCFG 13 hrs 1/2
 wouldn't take ga 220 MCFG
 1/2 ga 5,500 MCFG stabilized
 @ 3,500 MCFG. S.L. 6 hrs
 18 ga 3,650 MCFG Fiac?
 PB 5937 72/5902-14 18/
 5895-97 tst VSSC 2 hrs 1/2
 tst 60 MCFG @ 6050 JUL 24 '57 Fiac
 CO 6013 Both sets ga 2,530
 MCFG Flwd 3,460 MCFG 2" T89
 for 4 hrs FCP 1650# Flwd
 3,850 MCFG Thru T89 for 5 hrs
 comp. 4,285 MCFG CP 552#
 (tst) JUL 31 '57 complete out
 of both zones 2,530 MCFGpd.