


Morton

KANSAS

Section 27 Township 34 Range 41 W

Well No. # 1 Ward "D"

Company Cities Service Oil

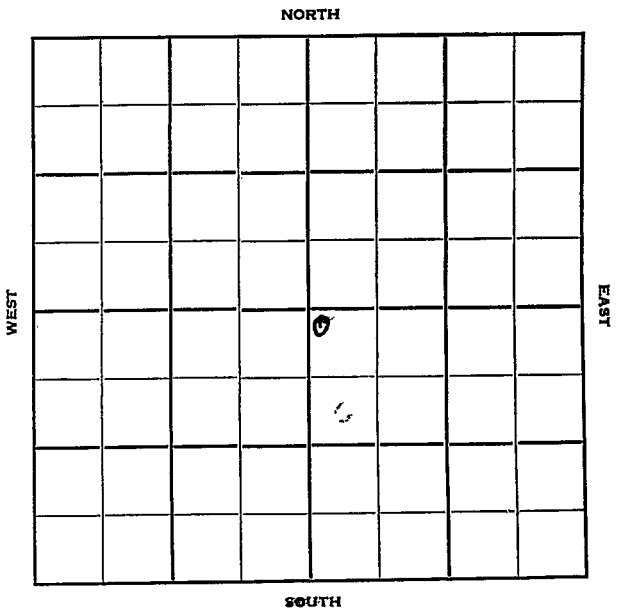

Morton

KANSAS

Sec. 27 Twp. 34 R. 41W

Well No. #1 Ward "D" Farm

Cities Service Oil

Company

Contractor

100

Ft. from N. Line


Ft. from S. Line

Ft. from E. Line

100

Ft. from W. Line

NW SE

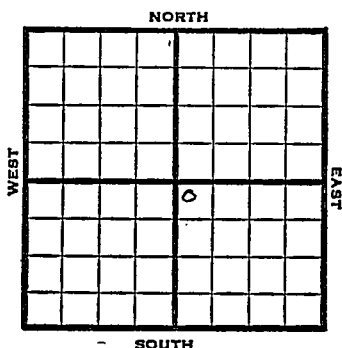

1952

Elev. 3428' REPORT

3/19

Spud 3-13-52

8" @ 360'

Drlg. 2040'

3/25

RTD 2375' 5" @ 2374' 50/2328-38

50/2312-22' 50/2782-92 40/2272-80

60/2256-68 Her 2226' Up Krider 2254'

2254' Low Krider 2272' Win 2323'

4/1

19,000 A

4/9

NR

4/16

Spud 3-13-52

Gas Well TD 2375

8" @ 360

5" @ 2374

TD 2375

50/2328-38 50/2312-22 50/2282-92

40/2272-80 60/2256-68 Her. 2226

Kri 2254 Win 2323 19,000 A

Comp. 3,230,000 gas

COMPLETED

County Morton State KansasSec. 27 (Blk.) 34 (Sur.) 41W Map No.Operator Cities Service OilWell No. 1 Farm Ward "D"Elev. Location NW SE

100 Ft. From N Line SE100 Ft. From W Line Quarter1st. Report MAR 19 1952

Completion

Remarks

Spudding Date 3-13-52

Drlg. Data

8" @ 360 drlg. 2040

J. G. McGEHEE

