

Morton

KANSAS

SECTION 27 TOWNSHIP 34 RANGE 42 W

WELL NO. #2 Hamilton "B"

COMPANY Cities Service

NORTH

						0	

WEST

EAST

SOUTH

Morton

KANSAS

SEC. 27	TWP. 34	R. 42W
------------	------------	-----------

WELL NO. #2 Hamilton "B" FARM

COMPANY Cities Service

CONTRACTOR

Greenwood


\_\_\_\_\_ Ft. from N. Line

\_\_\_\_\_ Ft. from S. Line

\_\_\_\_\_ Ft. from E. Line

\_\_\_\_\_ Ft. from W. Line

NW SE NE

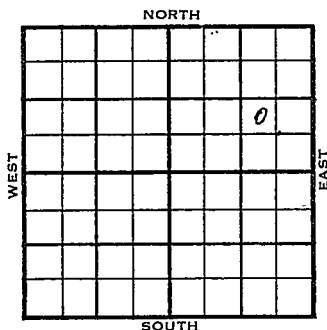

1956	ELEVATION 3520	REPORT
------	-------------------	--------

1-5 Comm. 12-30-55  
8" @ 1363/600

County Morton Elev. 3520  
 Sec. 27 Twp. 34 Rge. 42W  
 Company Cities Service  
 Farm Name Hamilton "B" No. 2

TOPS	DEPTH	LOG	DATUM
Anh.			
Tp.			
H.			
Tr.			
Dg.			
Bl.			
L.			
K.C.			
B.K.C.			
Ce.			
C.			
M.			
M.			
K.			
Mz.			
Ma.			
V.			
S.			
S.			
A.			
R.			
PE.			
G.			
T.D.			

Loc. in Sec. NW SE NE  
 Geol. \_\_\_\_\_  
 Contr. \_\_\_\_\_  
 Pool Greenwood  
 FIRST REPORT  
 0  
 JAN 5 '56

Date Comm. 12-30-55  
8" @ 1363/600

*34*

Co.  
Lse.  
No.  
Sec.  
T.  
R.